

Lot 36  
Name **Herbert Hiscock**

**WATER SERVICE RECORD**

Service No. **128**

Address **6 Fairbanks Road**

Location

~~Repair~~ ~~Renewal~~ ~~XXXXXX~~ ~~XXXXXX~~ ~~XXXXXX~~ ~~XXXXXX~~ ~~XXXXXX~~ ~~XXXXXX~~ ~~XXXXXX~~ ~~XXXXXX~~  
New Service

SERVICE IN TO CURB

Comm 11-17-58


Date	Material	Amount	Total	Date	Amount
7/3/58	Labor	4 09		7-2-58	35 00
	10% overhead	41	4 50	11-17-58	7 26
	45'-3/4" copper tubing @.37		16 65		NON CHARGE
	1-3/4" Cx 1/2" I.W.H. stop & waste		5 84	7/6/54	Labor
	1 hr. trucking @.75		75		25' - 3/4" Copper tubing@.35
			27 74		1 - 3/4" C. corp-cock
					1 - 3/4" C x 3/4" C. curb-cock
					1 box and rod
					1 hr. trucking
					25 25
					1-1/2" straight tail piece
				7/3/58	1-1/2" offset tailpiece
					50
					26 25

DATE \_\_\_\_\_

TOWN OF LEXINGTON — BOARD OF PUBLIC WORKS

WATER DIVISION

Sketch of Service Here

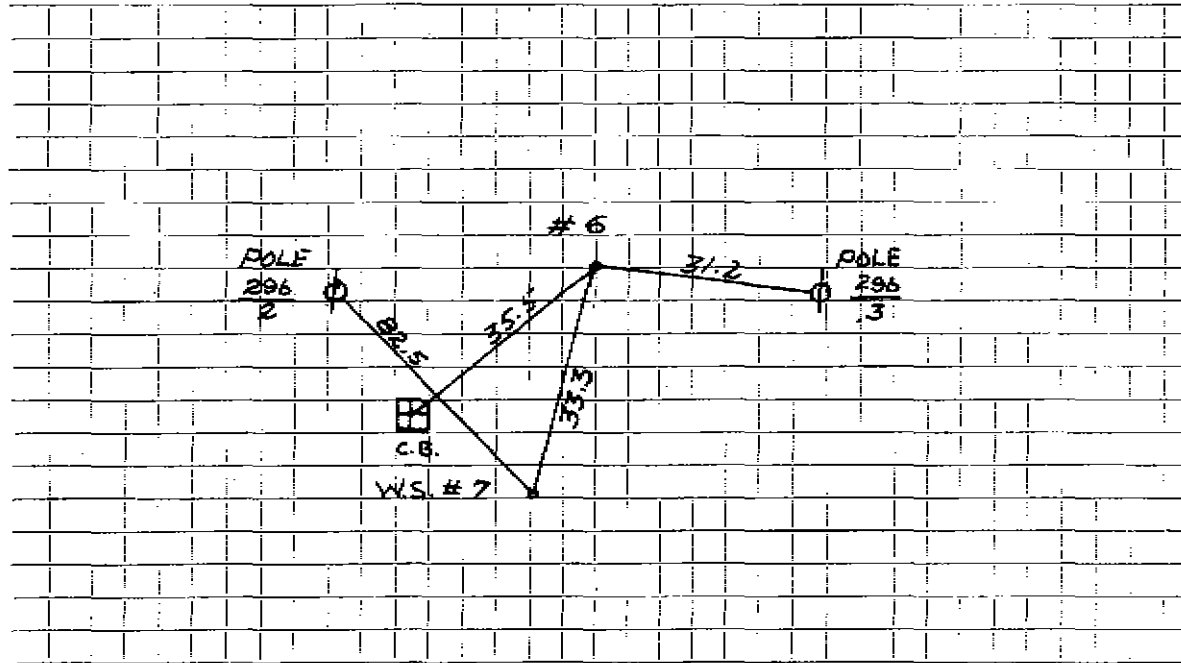

Connection made in ..... Street. Work completed .....

Remarks: .....

.....

.....