


DATE Sept 8 1997

TOWN OF LEXINGTON — BOARD OF PUBLIC WORKS
WATER DIVISION

Sketch of Service Here

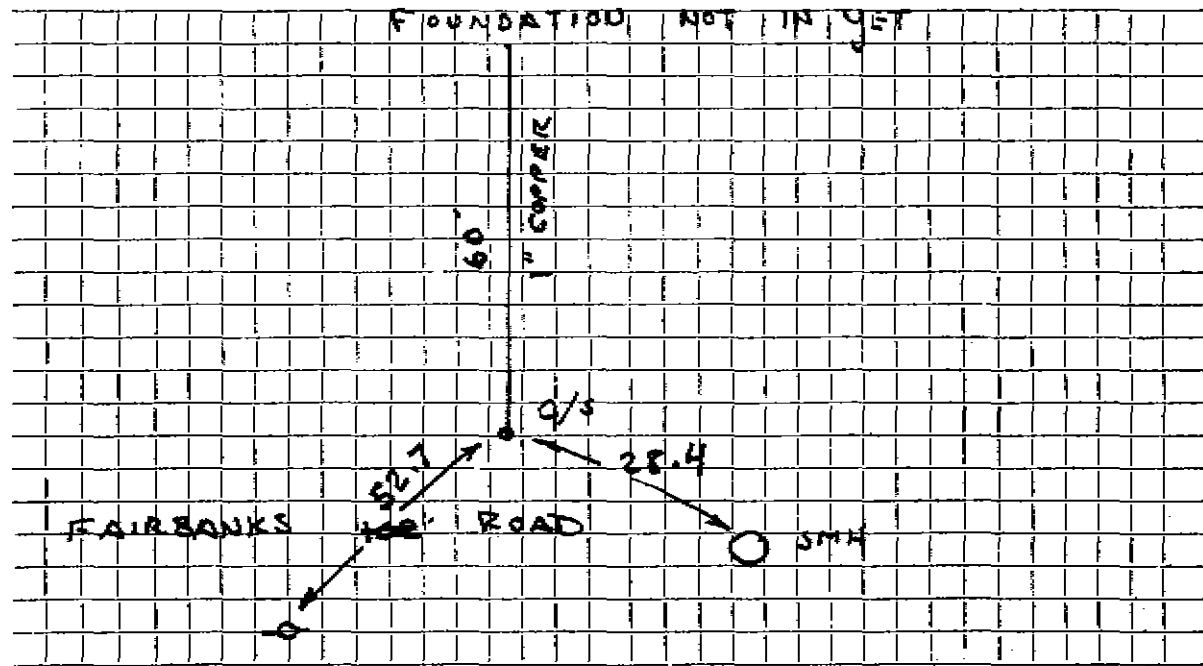

Connection made in FAIRBANKS Street. Work completed I.M. McLaughlin

Remarks: FOUNDATION NOT IN AT TIME OF INSPECTION

FIELD BOOK 97-3

TJM

WATER SERVICE RECORD

Name Richard & Barbara Hobart

Service No. 217

Address 7 Fairbanks Road

2799

Location

~~Repair~~ ~~Renewal~~ New Service

Comm. 10-8-56


| Date | Material | Amount | Total | Date | Amount |
|---------|----------------------------------|--------|-------|---------|------------------------------|
| 7/24/56 | Labor | 6 40 | | 7-20-56 | Deposit # 100 00 |
| | 10% Overhead | 64 | 7 04 | 10-8-56 | Refund 60 57 |
| | 55 3/4" Coppertubing @.4850 | | 26 68 | | 39 43 |
| | 1 3/4 Cx 1/2 I.W.H. Stop & Waste | | 4 96 | | |
| | 1 hr. trucking @.75 | | 75 | | NON CHARGE |
| | | | 39 43 | 1 1/2 | Straight tail piece 50 |
| | | | | 1 1/2 | Offset " " 50 |
| | | | | | NON CHARGE 1 00 |
| | | | | 6-4-54 | 6' 3/4" Copper Tubing |
| | | | | | 1 3/4" C Corp Cock |
| | | | | | 1 3/4" C x 3/4" C. Curb Cock |
| | | | | | 1 Box & Rod |

DATE _____

TOWN OF LEXINGTON - BOARD OF PUBLIC WORKS

WATER DIVISION

Sketch of Service Here

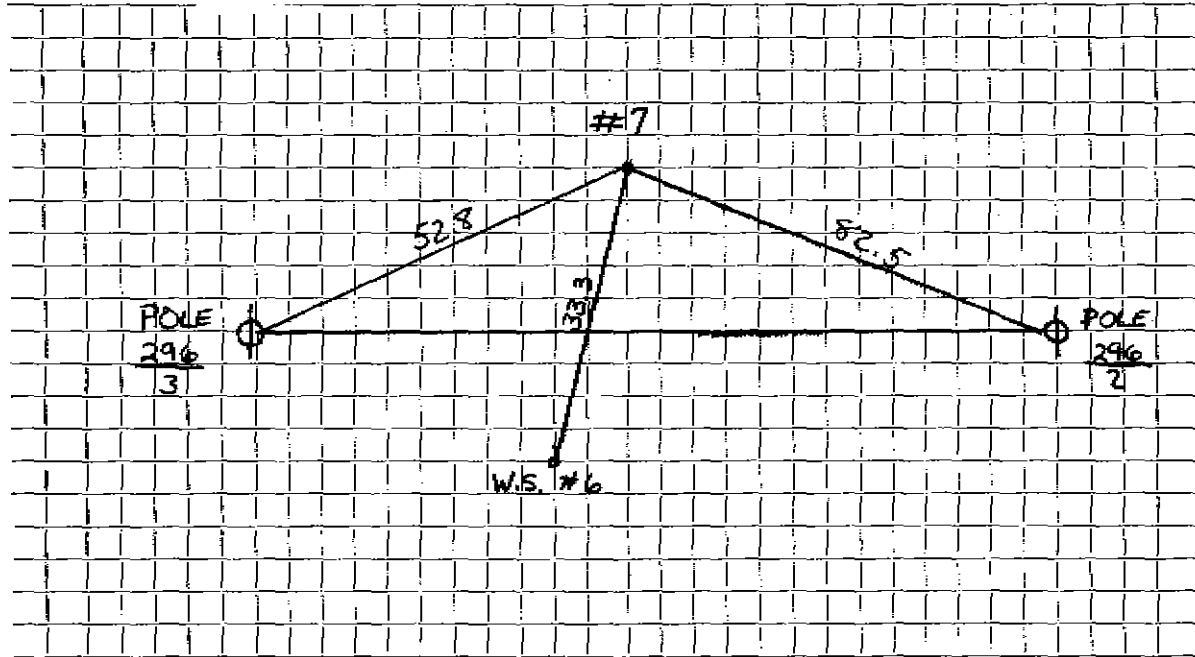

Connection made in Street. Work completed

Remarks:
.....
.....