


DATE _____

TOWN OF LEXINGTON — BOARD OF PUBLIC WORKS

WATER DIVISION

Sketch of Service Here

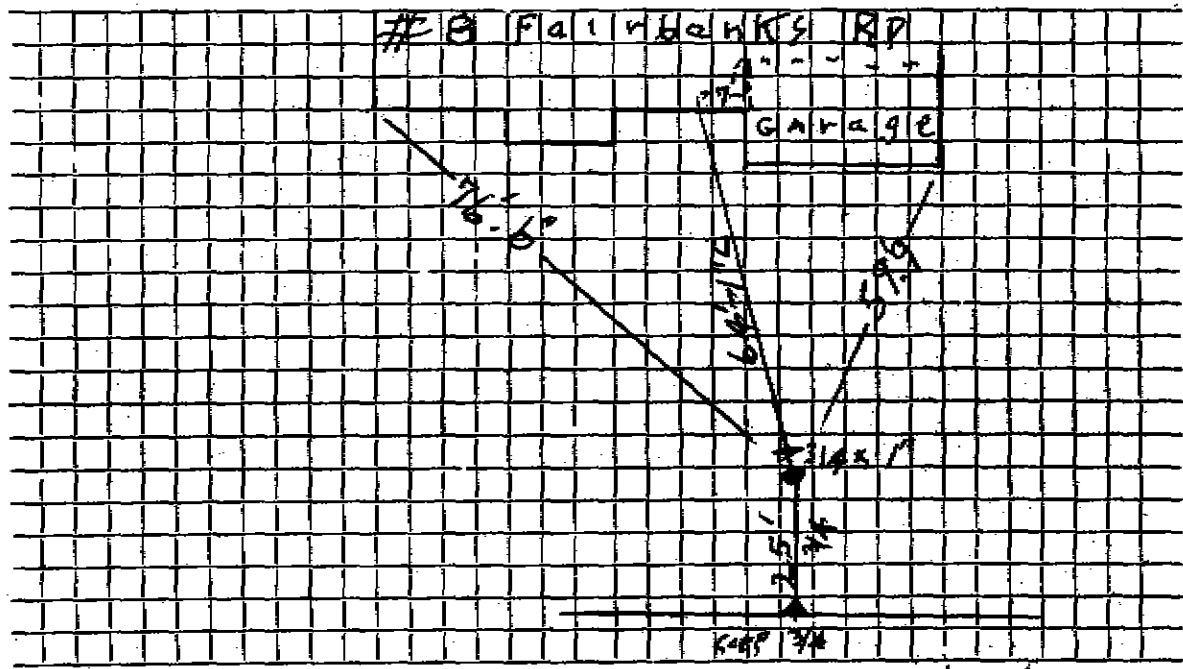

Connection made in _____ Street.

Work completed 5/20/08 J. Mel.

Remarks: _____

