


HSE #15

DATE _____

TOWN OF LEXINGTON BOARD OF PUBLIC WORKS
WATER DIVISION

Sketch of Service Here

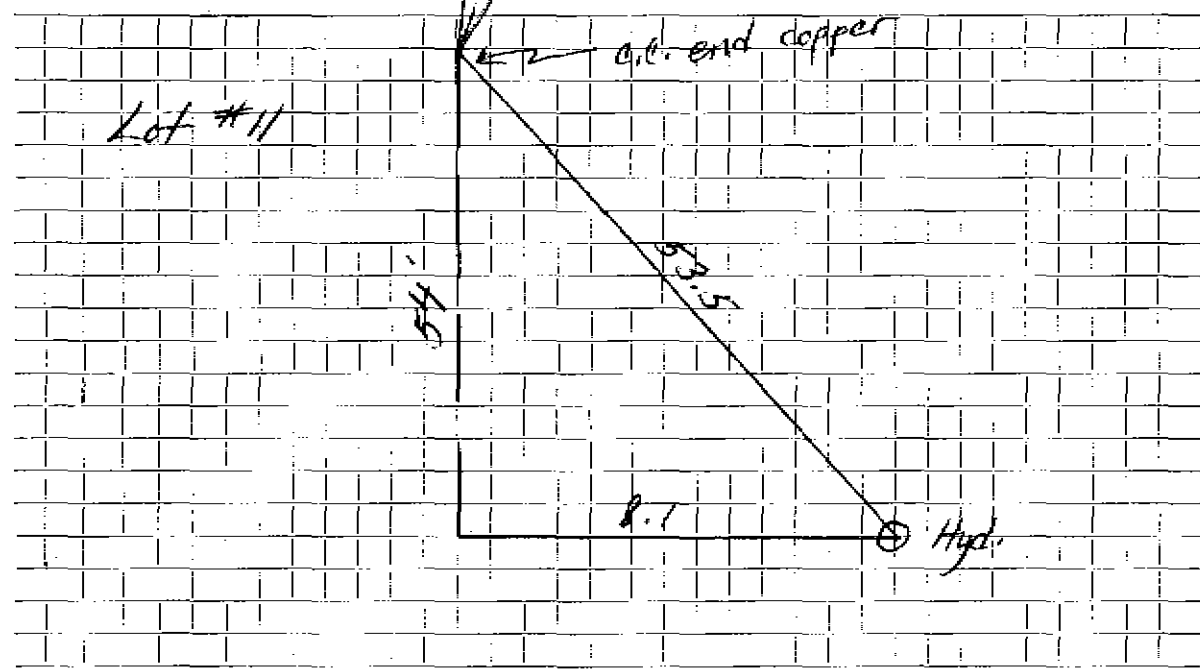

Connection made in Street. Work completed

Remarks:
.....
.....