WATER SERVICE RECORD


Name		Oak Park Corp. Service No.										
Address		17 Fairfield Drive										
Loca	tion											
Repa	ir—R	enewal-New Service	Lucente	#1	597							
Date		Material	Amount		Total	Total				Amount		
-1-70	77'	3/4" Copper tubing										
	<u> </u>		; }	 	 		}	}] 	}	 	
	 	!	 		 	<u> </u>	 		<u> </u>	<u> </u>		
	 				 	! 	[<u> </u>		<u> </u>		
	 		·		[[<u> </u>	-	{ 	
	 		<u> </u>		<u></u>	 	<u>;</u>	<u> </u>		ļ ————————————————————————————————————	<u> </u>	
	}}					}1				<u></u> '		
	 				<u>-</u>	}		ļ			L	
	 			i	<u>-</u>	ļ —— - i		}		·	<u> </u>	
	{{			 			·	<u> </u>		 	L———	
	 	!		 			ļ					
	 				}		i	{		 		
	}	<u> </u>		! 	L		ļ 	<u> </u>			L	
	<u> </u>					ļ				 		
	1				ļ		,	<u> </u>		 		
	 			<u> </u>	<u> </u>		<u> </u>					
	†				 	t		ļ				
		 		<u> </u>	 	 			 		·	

-	~	-	

TOWN OF LEXINGTON - BOARD OF PUBLIC WORKS

WATER DIVISION

Sketch of Service Here

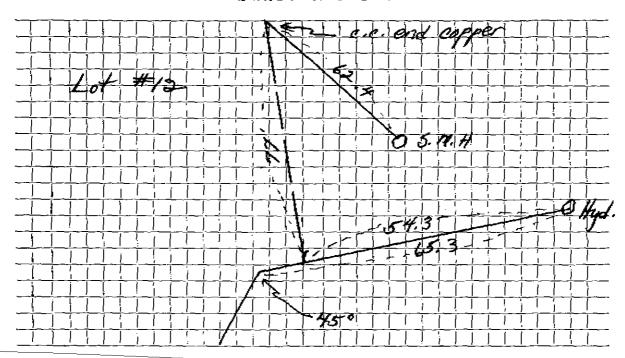

Connection made in	. Street.	Work completed	 •
Remarks:			
***************************************		, , , , , , , , , , , , , , , , , , , ,	