




DATE \_\_\_\_\_

TOWN OF LEXINGTON — BOARD OF PUBLIC WORKS  
WATER DIVISION

Sketch of Service Here  
Lot #18

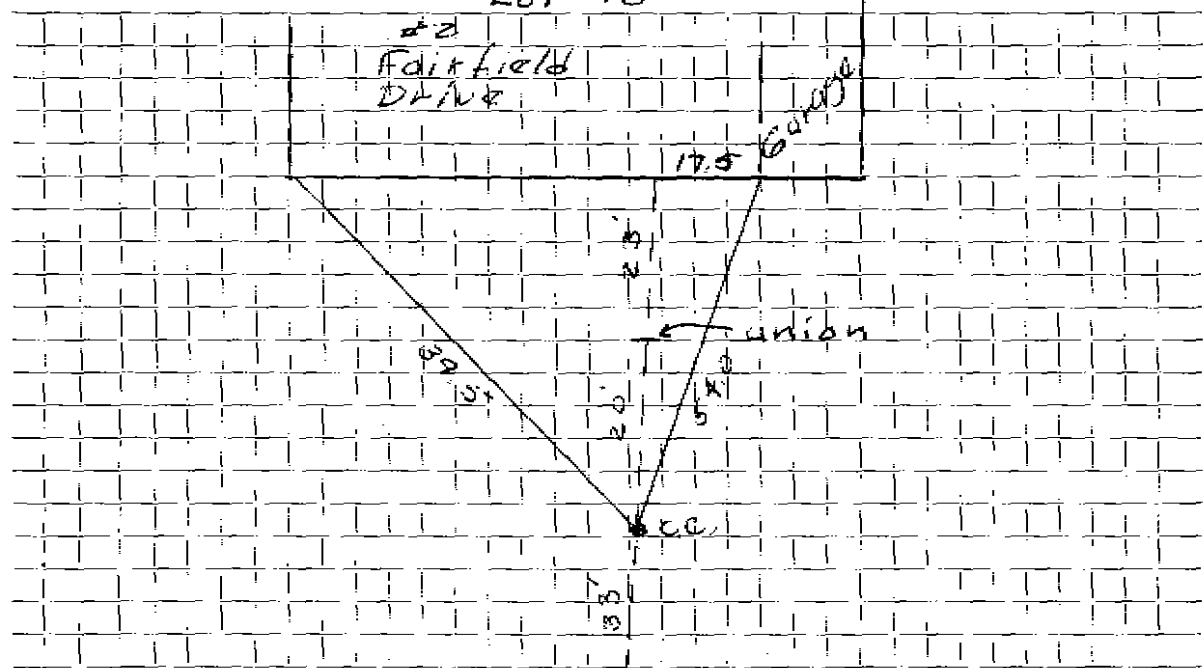

Connection made in Fairfield Drive Street. — Water Main Work completed .....

Remarks: .....

.....

.....