


TOWN OF LEXINGTON -- BOARD OF PUBLIC WORKS

WATER DIVISION

GARAGE

Sketch of Service Here

FRONT
43.9'

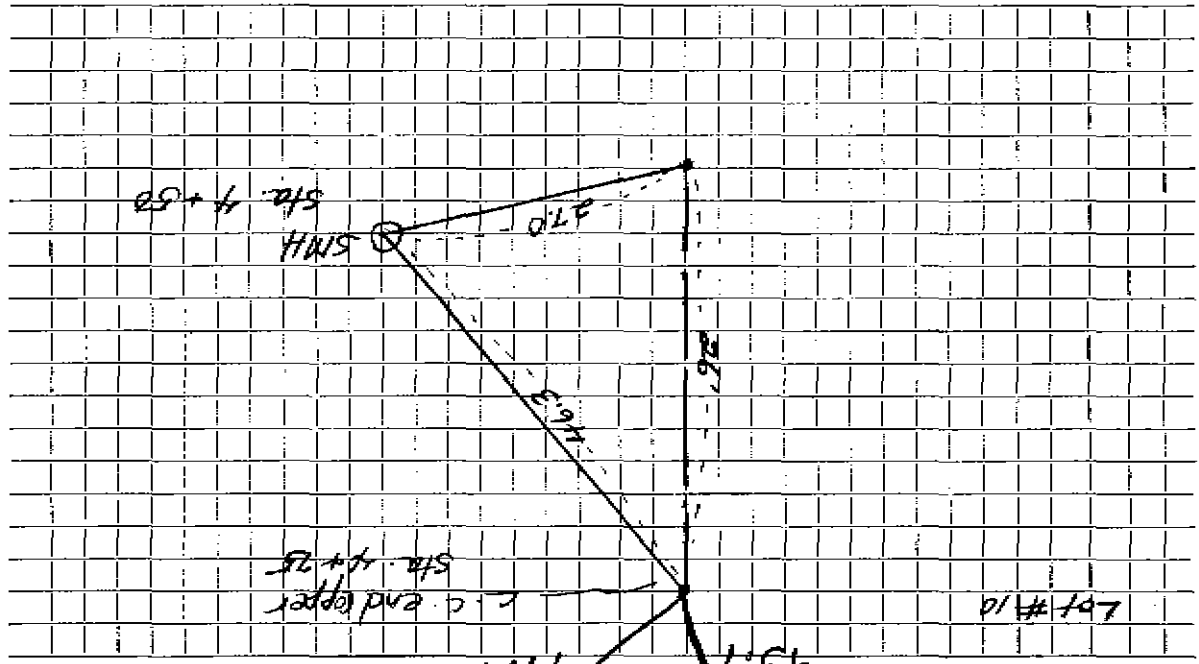

Lot #10

c. end copper
sta. 14+25

SMH
sta. 14+58

37.0

46.3

26.7

49.9

43.9'

Connection made in Street. Work completed

Remarks:

DATE