




DATE

BOARD OF PUBLIC WORKS

TOWN OF LEXINGTON

WATER DIVISION

#6

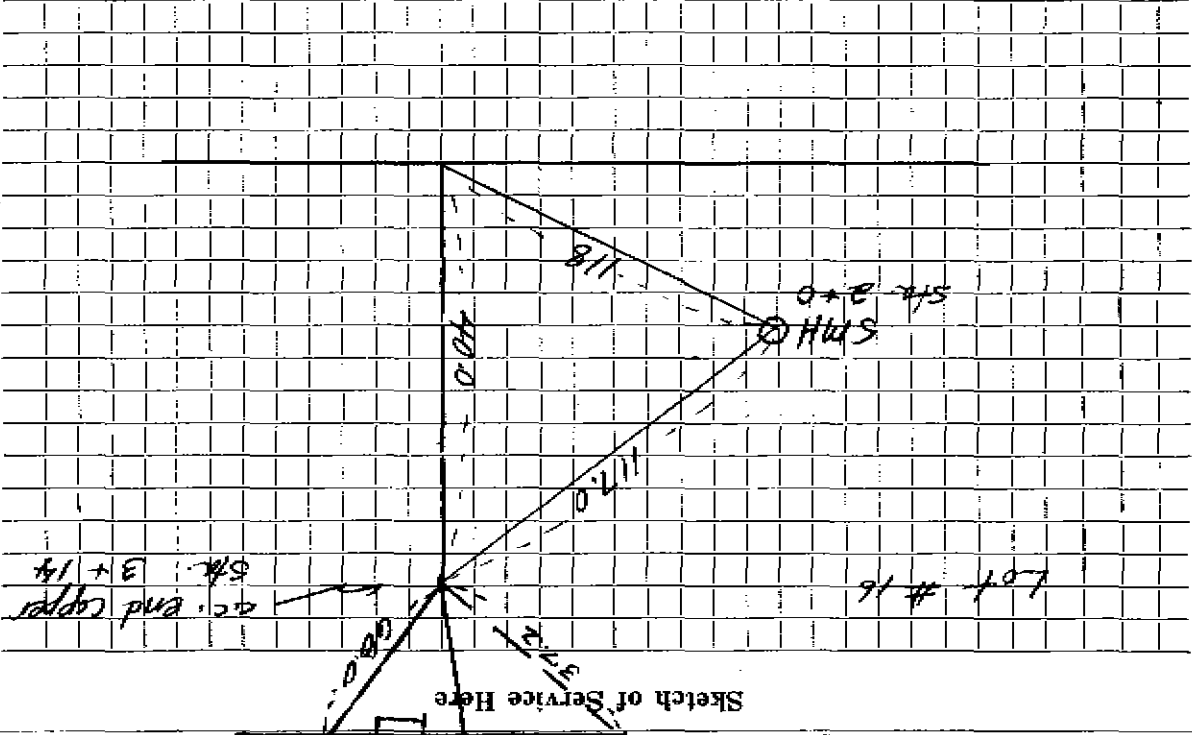

Connection made in

Street.

Work completed

Remarks: