

WATER SERVICE RECORD

Name Oak Park Corp.

Service No.

Address 7 Fairfield Drive

Location sta. 3 & 56

Repair—Renewal—New Service

Licente # 1985


Lucento #1591

Remarks:

Connection made in

Street

Work completed

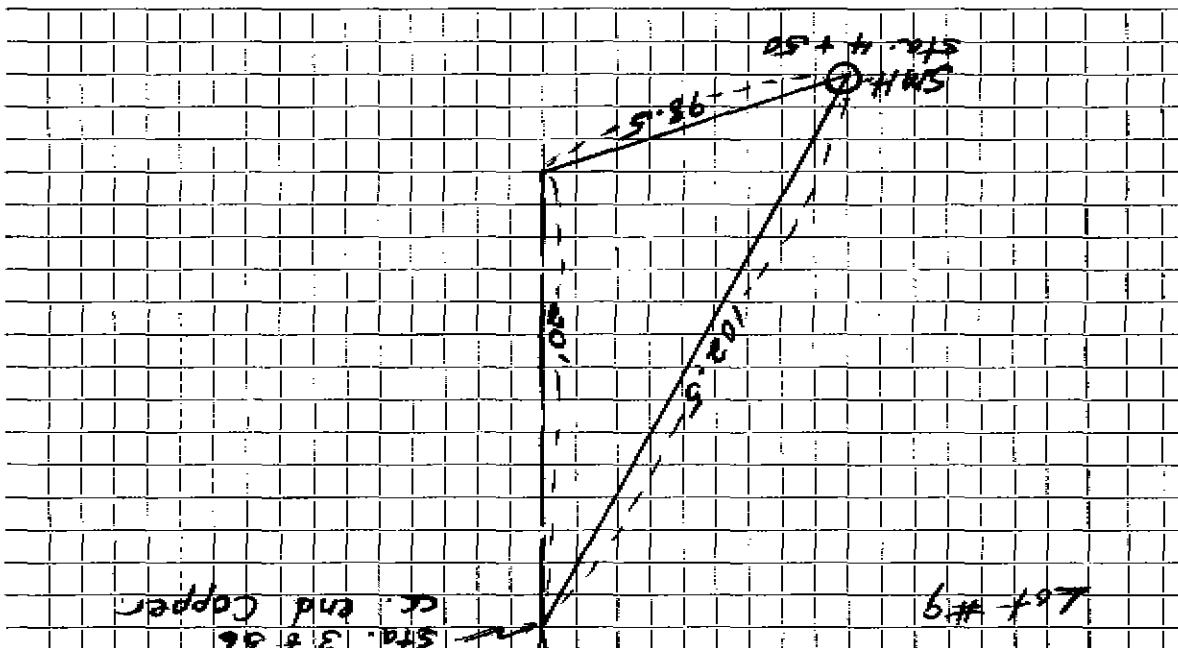

Sketch of Service Here

WATER DIVISION

TOWN OF LEXINGTON - BOARD OF PUBLIC WORKS

DATE

HSE