

WATER SERVICE RECORD

Name Herbert McConchie

Service No. 343 (1955)

Address 1 Fairland Street

Location

~~Repair - Renewal~~ - New Service

Service was in to curb


Date	Material	Amount	Total	Date	Amount
10/21/55	Labor	1 90		10-25-55	Repair
	10% overhead	19	2 09	8-6-56	Refund
	38' - 3/4" Copper tubing @ .495	18 95	18 98		NON CHARGE
	1 - 3/4Cx $\frac{1}{2}$ I.W.H. Stop & Waste		4 96	1 - $\frac{1}{2}$ " Straight tailpiece	50
	1 hr. trucking		75	1 - $\frac{1}{2}$ " Offset tailpiece	50
			26 78		1 00
				6/28/55	
				22'	3/4 COPPER
				1	3/4 COP
				1	3/4 Curb Cock
					Bole Rod

TOWN OF LEXINGTON — BOARD OF PUBLIC WORKS

WATER DIVISION

DATE _____

Sketch of Service Here

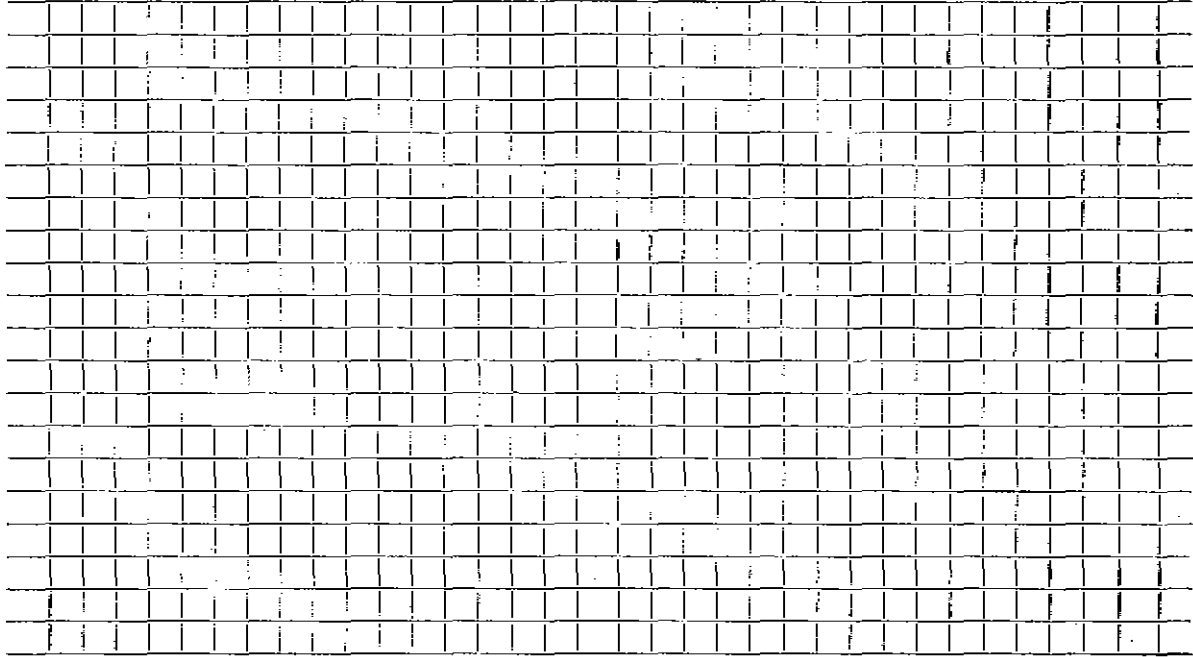

Connection made in

Street

Work completed

Remarks:

