


Date: 5/3/24

TOWN OF LEXINGTON - BOARD OF PUBLIC WORKS  
WATER DIVISION

SKETCH OF SERVICE HERE  
FAIRLAND COMMONS (15 FAIRLAND)

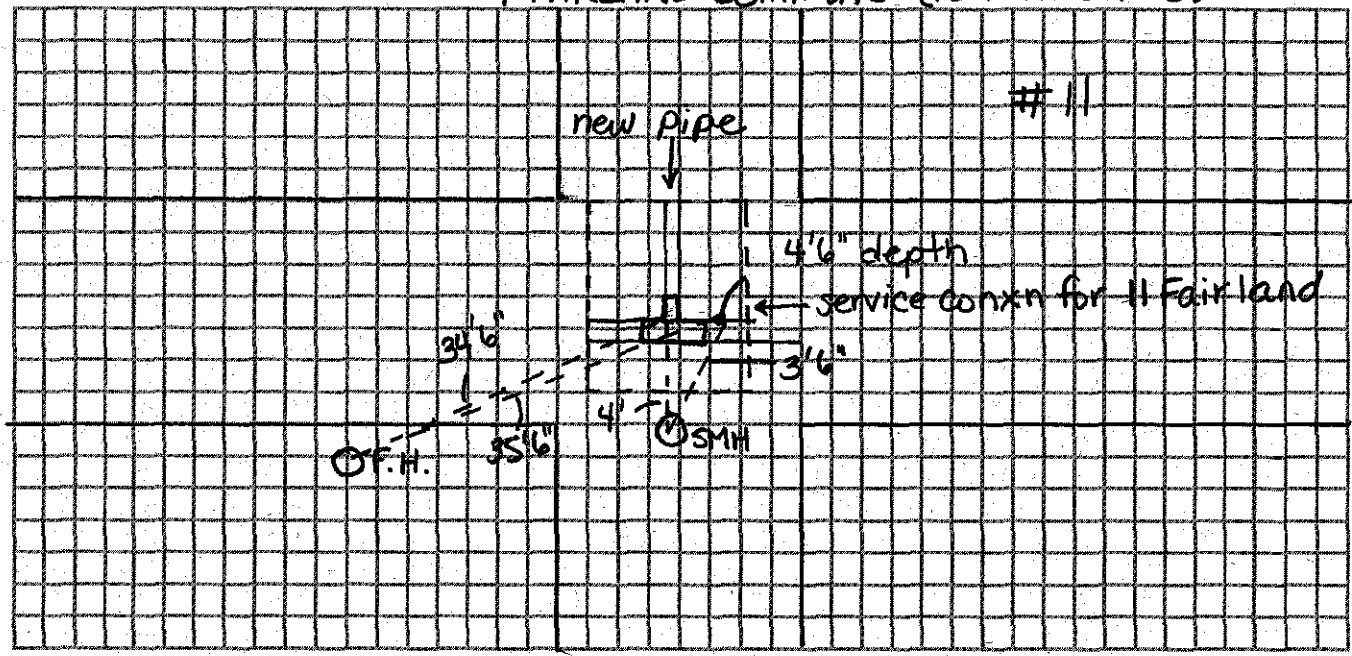

Connection made in:

Street.

Work completed:

Remarks: Installed by Baystate Engineering

