

WATER SERVICE RECORD

Name Herbert McConchie

Service No. 211

Address 16 Fairland Street

# 2651

Location

~~Repair~~ ~~Renewal~~ New Service

Comm 12-31-58


Date	Material	Amount	Total	Date	Material	Amount
10-15-58	Labor	3.76		10-14-58	Deposit	50.00
	10% O.H.	.38	4.14	12-31-58	Refund	17.07
	60' 3/4" Copper tubing @.37		22.20			32.93
	1 3/4" C x 1/2 I.W.H. Stop & Waste		5.84		NON CHARGE	
	1 hr. Trucking @.75		.75		1 1/2 Straight tailpiece	.50
			32.93		1 1/2 Offset tailpiece	.50
						1.00

DATE \_\_\_\_\_

TOWN OF LEXINGTON — BOARD OF PUBLIC WORKS

WATER DIVISION

Sketch of Service Here

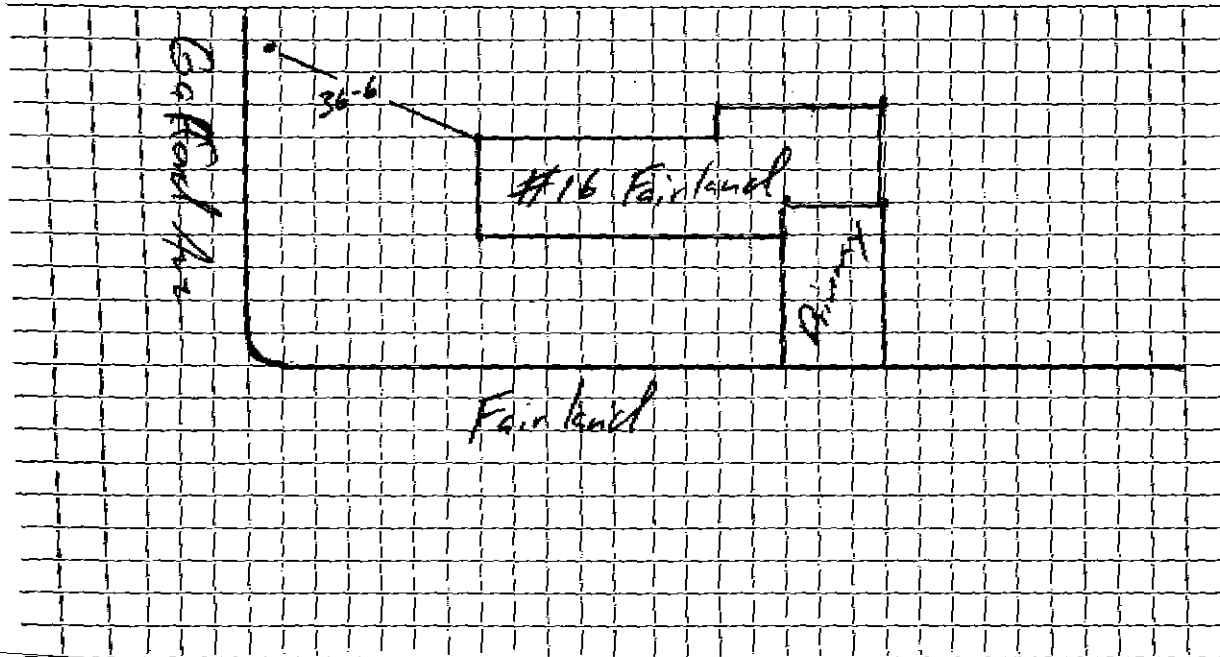

Connection made in Cottrell Ave Street. Work completed \_\_\_\_\_

Remarks: \_\_\_\_\_  
\_\_\_\_\_  
\_\_\_\_\_