

WATER SERVICE RECORD

#4187

Name Herbert McConchie

Service No. 181

Address 18 Fairland Street

Location

Repair ~~Renewal~~ — New Service

Comm. 11-18-57


Date	Material	Amount	Total	Date	Amount
9/12/57	labor	1 76		8-16-57	Deposit \$ 50.00
	10% overhead	18		11-18-57	Refund 23 60
			1 94		NON Charge \$ 26 40
	50' 3/4" copper tubing @.375	18 75			Labor 3 52
	1 3/4" Cx 1/2 IWH stop & waste	4 96		20' 3/4" copper tubing @.375	7 50
	1 hr. trucking @.75	75		1 3/4" C. corp cock	4 64
			26 40	1 3/4" C curb cock	5 94
				1 box & rod	4 62
				1 1/2 straight tail pc.	50
				1 1/2 offset tail pc.	50
					27 22

DATE _____

TOWN OF LEXINGTON — BOARD OF PUBLIC WORKS

WATER DIVISION

Sketch of Service Here

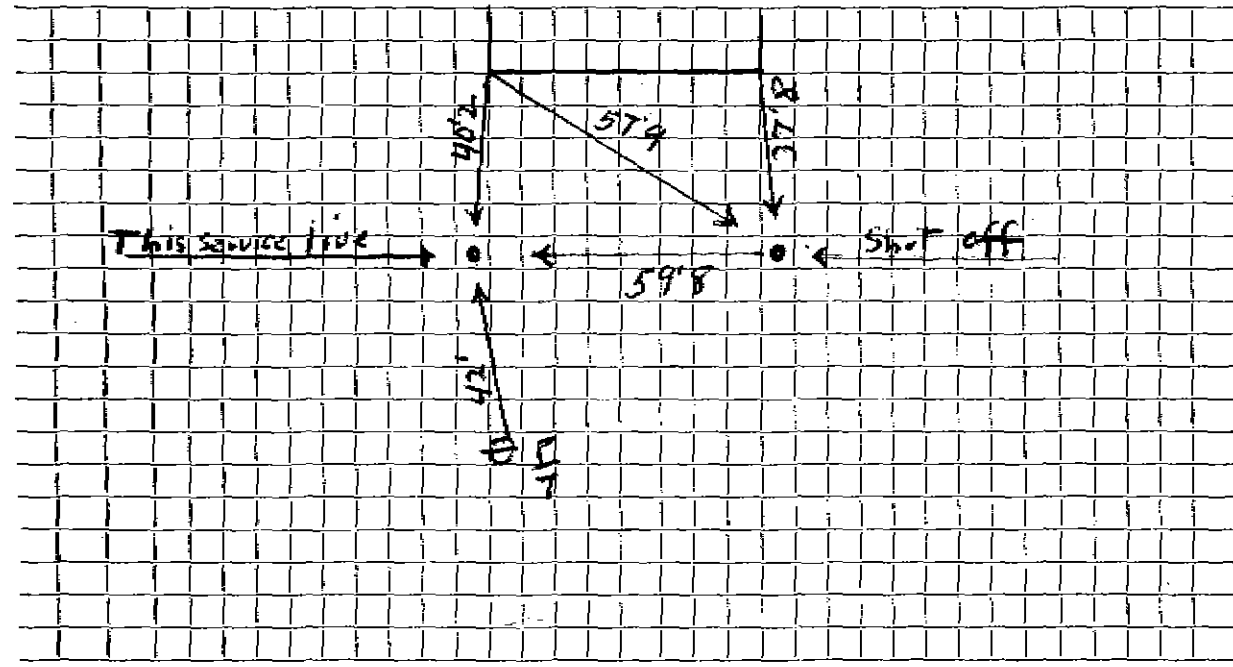

Connection made in Street. Work completed

Remarks:
.....
.....