

WATER SERVICE RECORD

#6178

Name Herbert G. McConchie

Service No. 30 #6187

Address 20 Fairland Street

Location

~~XXXXXXXXXXXX~~ New Service

Comm 8-4-58


Date	Material	Amount	Total	Date	Amount
4-15-58	Labor	3.95		3-25-58	50 00
	10% overhead	.40	4.35	8-4-58	22 23
	38' 3/4" Copper tubing @.37		14.06		27 27
	1 3/4" C x 1/2" I.W.H. Stop & Waste		5.84		<u>NON CHARGE</u>
	1 3/4" C 3 part union		2.27	6/12/56	Labor 1 90
	1 hr. trucking @.75		.75		16' 3/4" Copper tubing @.4396 7 03
			<u>27.27</u>		1 3/4" C Corp Cock 4 64
					1 3/4" C Curb Cock 5 94
					1 Box & Rod 4 62
					<u>24 13</u>
					1 1/2 Straight tail piece .50
					1 1/2 Offset tail piece .50
					<u>25.13</u>

DATE _____

TOWN OF LEXINGTON — BOARD OF PUBLIC WORKS

WATER DIVISION

Sketch of Service Here

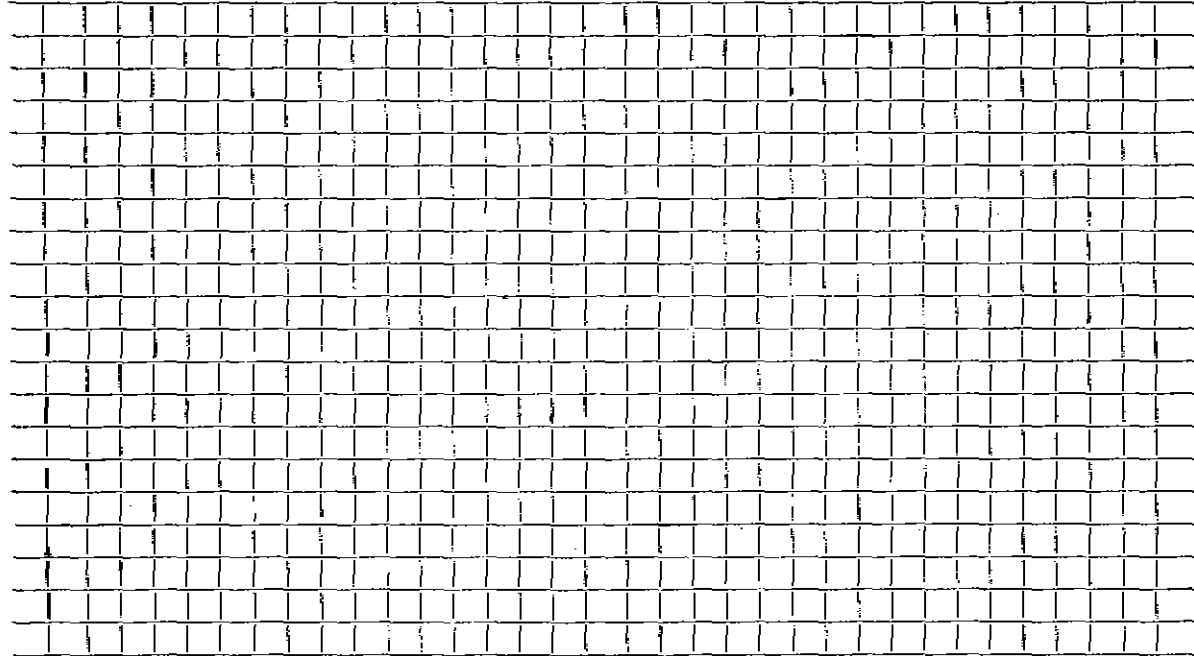

Connection made in Street. Work completed

Remarks:

.....

.....