

WATER SERVICE RECORD

Service No. 1799

Name

Address

21 Fairland St

Location

Repair—Renewal—New Service

T. D. J. McLaughlin


Date	Material	Amount	Total	Date	Amount
6/22/05	149.00 1" Copper 3/4 X 1" increaser Buff 10 box			4/2/06	20 3/4 Copper 3/4 cor P 3/4 Curb

DATE _____

TOWN OF LEXINGTON — BOARD OF PUBLIC WORKS

WATER DIVISION

Sketch of Service Here

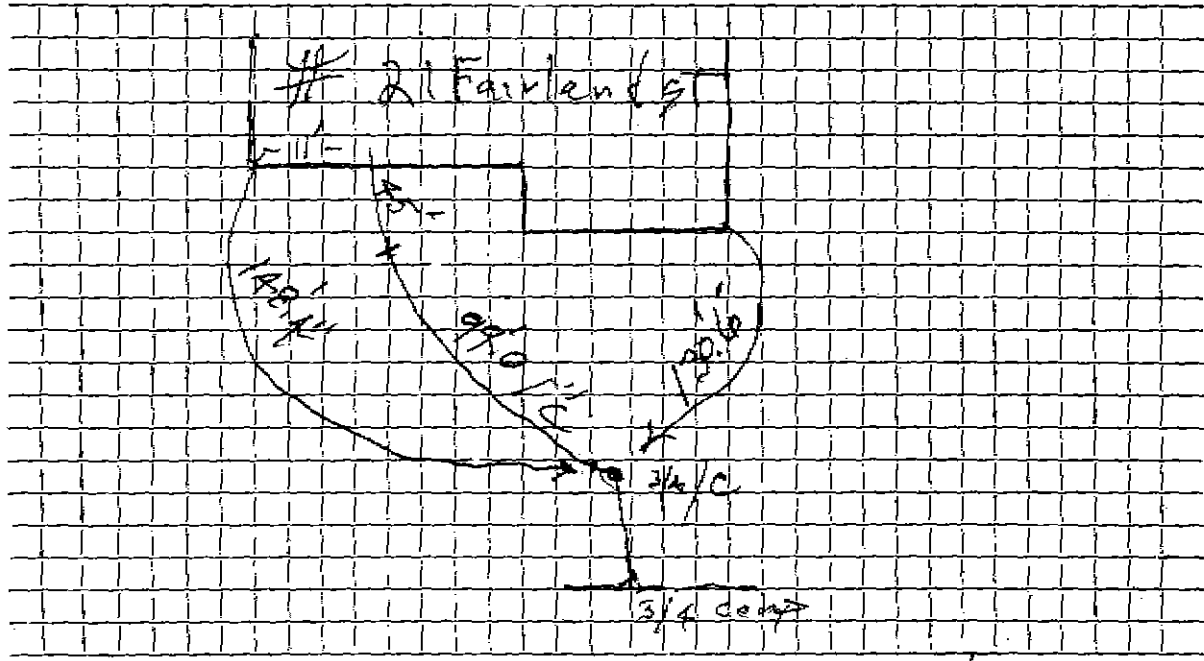

Connection made in Street. Work completed 6/22/05 J. H. H.

Remarks: Water & Sewer were in same trench

.....
.....