

WATER SERVICE RECORD

#3324

Name Charles H. Murray

Service No. 261

Address 22 Fairland Street

Location

~~Service Renewal~~ - New Service

Comm 3-16-59


Date	Material	Amount	Total	Date	Material	Amount
11/22/58	Labor	1 85		11-12-58	Deposit	35 00
	10% overhead	19	2 04			
	60' - 3/4" Copper tubing @ .37	.37	22 20	3-16-59	* Refund	5 37
	1 - 3/4"		4 64			29 63
	1 hr. Trucking		75		NON CHARGE	
			29 63	8-13-58	Labor	3 70
					15' 3/4" Copper tubing @ .37	5 55
					1 3/4" C Corp Cock	4 64
					1 3/4" C Curb Cock	6 03
					1 Box & Rod	5 00
						24 92
				11/22/58	Labor	1 85
					24' - 3/4" Copper tubing @ .37	8 88
					1 - 3/4" C. Corp Cock	4 64
					1 - 3/4" C. Curb Cock	6 03
					1 Box & Rod	5 00
					1 - 1/2" Straight tailpiece	50
					1 - 1/2" Offset tailpiece	50
						27 40

\* Applied to service # 277

DATE \_\_\_\_\_

TOWN OF LEXINGTON — BOARD OF PUBLIC WORKS  
WATER DIVISION

Sketch of Service Here

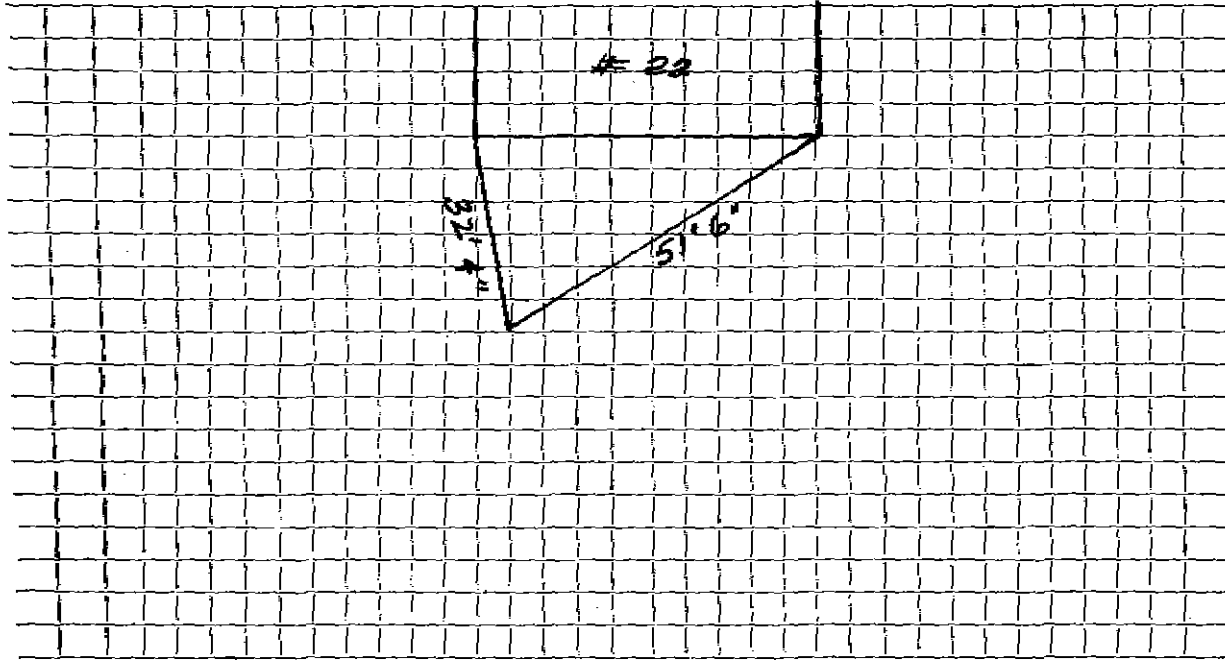

Connection made in ..... Street. Work completed .....

Remarks: .....  
.....  
.....