

WATER SERVICE RECORD

Name Herbert McConchie

Service No. 244

Address 28 Fairland street

3475

Location Lot 29 PT of 30

-Repair--Renewal--New Service

Comm 3-16-59


Date	Material	Amount	Total	Date	Amount	
11/22/58	Labor	1 85		11-7-58	Deposit	3 50
	10%	19	2 04	3-16-59	Refund	7 87
	50' - 3/4" Copper tubing @ .37		18 50			27 13
	1 - 3/4" Cx 1/2 I.W.H. Stop & Waste		5 84		NON CHARGE	
	1 hr. Trucking		75	11/22/58	1 - 1/2 Offset tailpiece	50
			27 13		1 - 1/2 Straight tailpiece	50
				6/13/58		100
					20' 3/4 COPPER	
					1 3/4 CORP	
					1 3/4 CURB COCK	
					1 Box & Rod	

* Applied to S.H.C. #199

DATE _____

TOWN OF LEXINGTON — BOARD OF PUBLIC WORKS
WATER DIVISION

Sketch of Service Here

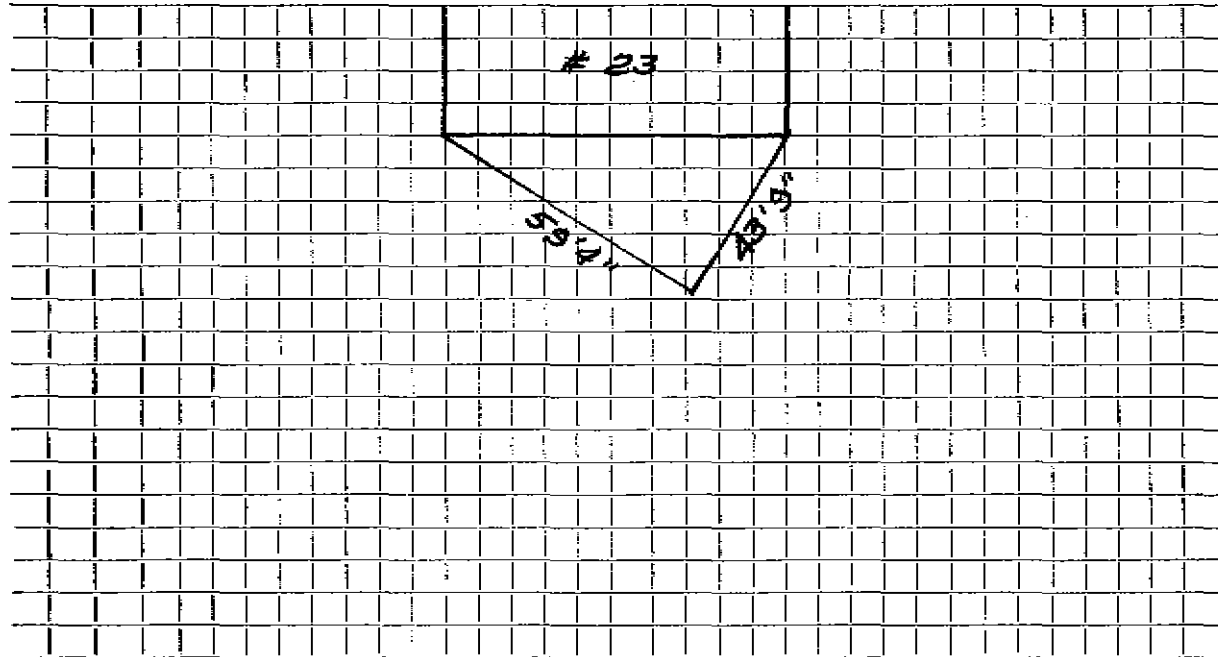

Connection made in Street. Work completed

Remarks:
.....
.....