

WATER SERVICE RECORD

3352

Name John N. Reichheld

Service No. 82

Address 29 Fairland Street

#7339

Location

~~Repair~~ ~~Reconnect~~ New Service


Comm 7-17-61

Date	Material	Amount	Total	Date	Amount	
6-14-61	Labor	2.04		6-14-61	Deposit	50.00
	10% O.H.	.20	2.24	7-17-61	Refund	11.04
67'	3/4" Copper Tubing @.42		28.14			38.96
1	3/4" C x 1/2 I.W.H. Stop & Waste		6.17		NON CHARGE	
1	3/4" C 3 part union		2.41	7-29-59	Labor	3.70
			38.96	46'	3/4" Copper tubing @.38	17.48
				1	3/4" C Corp Cock	4.67
				1	3/4" C Curb Cock	6.07
				1	Box & Rod	5.00
						36.92
				6-14-61	1 1/2 Straight tailpiece	.50
					1 1/2 Offset tailpiece	.50
						37.92

DATE \_\_\_\_\_

**TOWN OF LEXINGTON — BOARD OF PUBLIC WORKS**  
**WATER DIVISION**

Sketch of Service Here

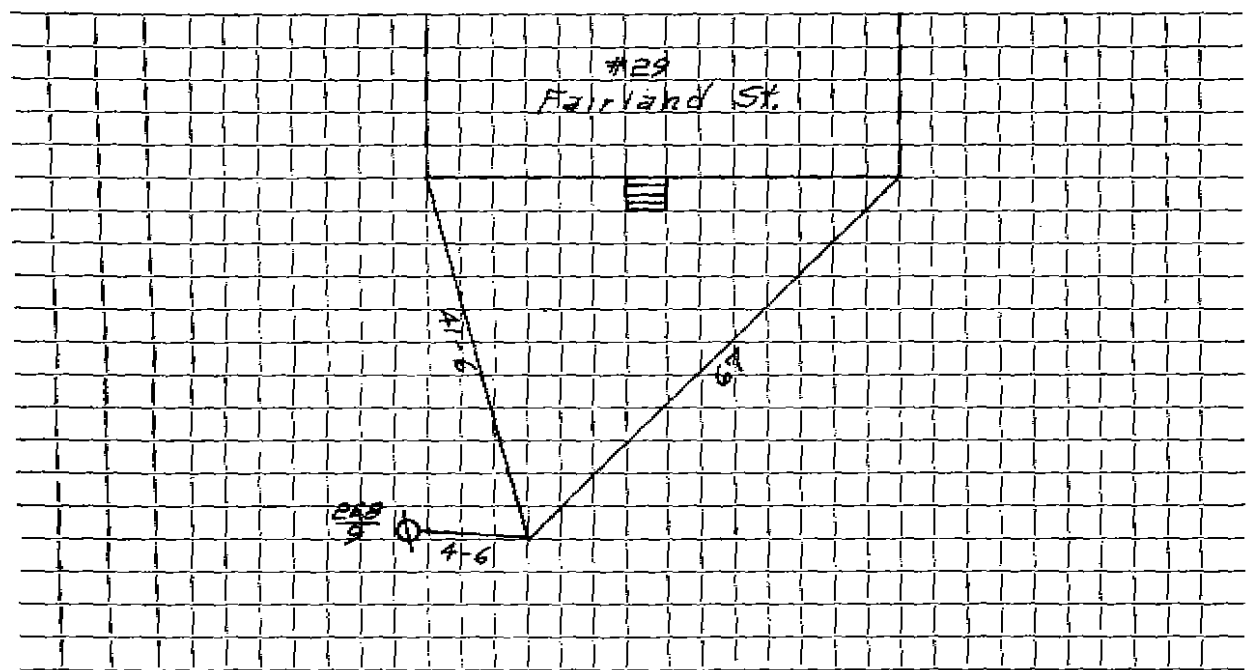

Connection made in ..... Street. Work completed .....

Remarks: .....  
.....  
.....