

WATER SERVICE RECORD

#5332

Name Herbert McConchie

Service No. 288

Address 8 Fairland Street

Location

~~Repair~~ ~~Renewal~~ New Service

Comm. 3-3-58


Date	Material	Amount	Total	Date	Amount
12/23/57	Labor	1 76		12-13-57	Deposit \$ 50.00
	10% overhead	18	1 94	3-3-58	Refund 29.40
	35' - 3/4" Copper tubing @ .37	12 95			NON CHARGE \$ 20.60
	1 - 3/4" Cx 1/2 I.W.H. Stop & Waste	4 96			
	1 hr. Trucking		75		Labor 1 76
			20 69	28' - 3/4" Copper tubing @ .37	10 36
				1 - 3/4" C. Corp Cock	4 64
				1 - 3/4" C. Curb Cock	5 94
				1 Box & Rod	4 62
				1 - 1/2 Straight tailpiece	50
				1 - 1/2 Offset tailpiece	50
					<u>28 32</u>

DATE _____

TOWN OF LEXINGTON — BOARD OF PUBLIC WORKS

WATER DIVISION

Sketch of Service Here

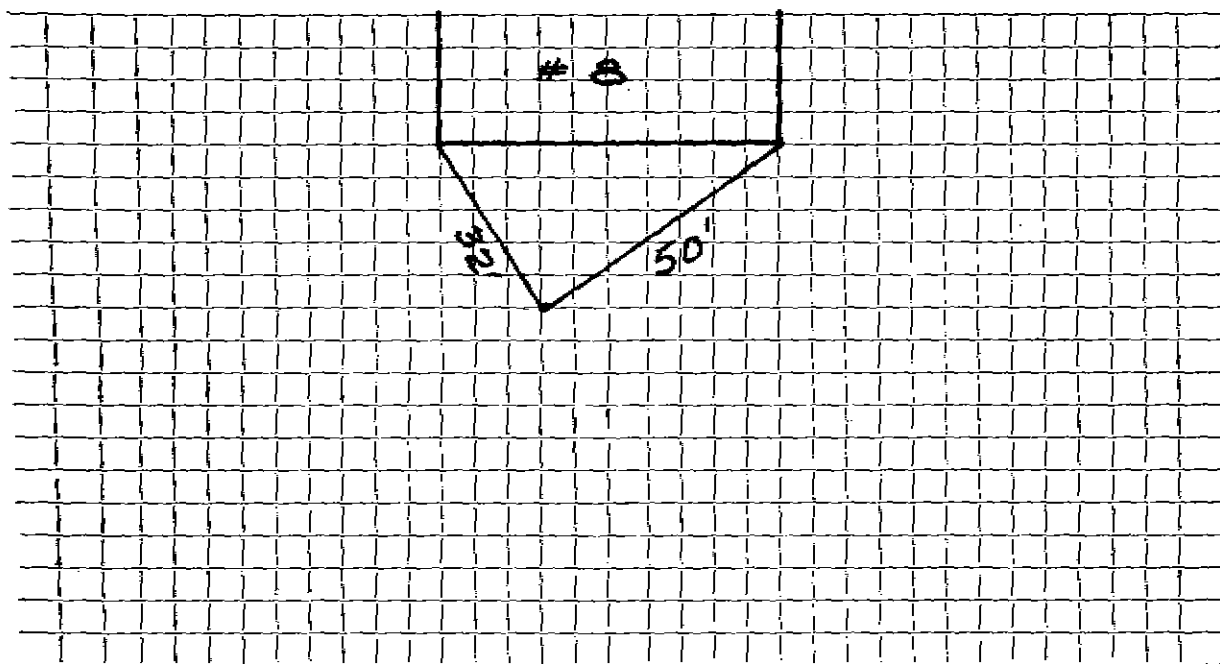

Connection made in Street. Work completed

Remarks:
.....
.....