

WATER SERVICE RECORD

4724

Name Robert L. Johnson

Service No. 3111

Address 9 Fairland Street

Location

Repair ~~Renewal~~ - New Service

Conn, 12-31-55


Date	Material	Amount	Total	Date	Amount
11/22/55	Labor	1 85		12-25-55	Deposited # 70 00
	10% overhead	19	2 04	12-31-55	Refunded (16 69
	80' - 3/4" copper tubing @ .56	44 80			NON CHARGE 53 31
	1 - 3/4" C. Union (3 parts)	1 72		Labor	1 85
	1 - 3/4" x 1/2" I.W.F. Stop & Waste	2 00		15' - 3/4" copper tubing @ .56	8 40
	1 hp. trucking		75	1 - 3/4" C. Corp Cock	1 33
			53 31	1 - 3/4" C. Curb Cock	1 67
				1 box 1/2 rod	3 90
				1 - 1" straight tail piece	50
				1 - 1" offset tail piece	50
					26 55

DATE _____

TOWN OF LEXINGTON — BOARD OF PUBLIC WORKS

WATER DIVISION

Sketch of Service Here

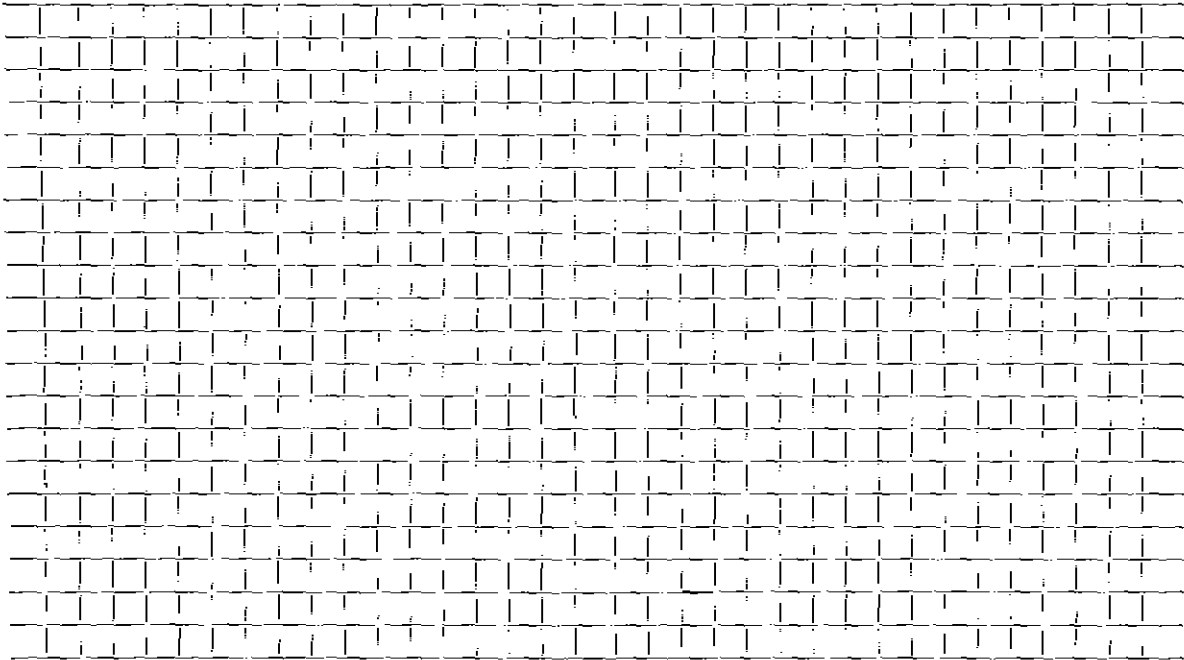

Connection made in Street. Work completed

Remarks:
.....
.....