




Date: 06/14/24

TOWN OF LEXINGTON - BOARD OF PUBLIC WORKS  
WATER DIVISION

SKETCH OF SERVICE HERE  
10 Fairlawn St.

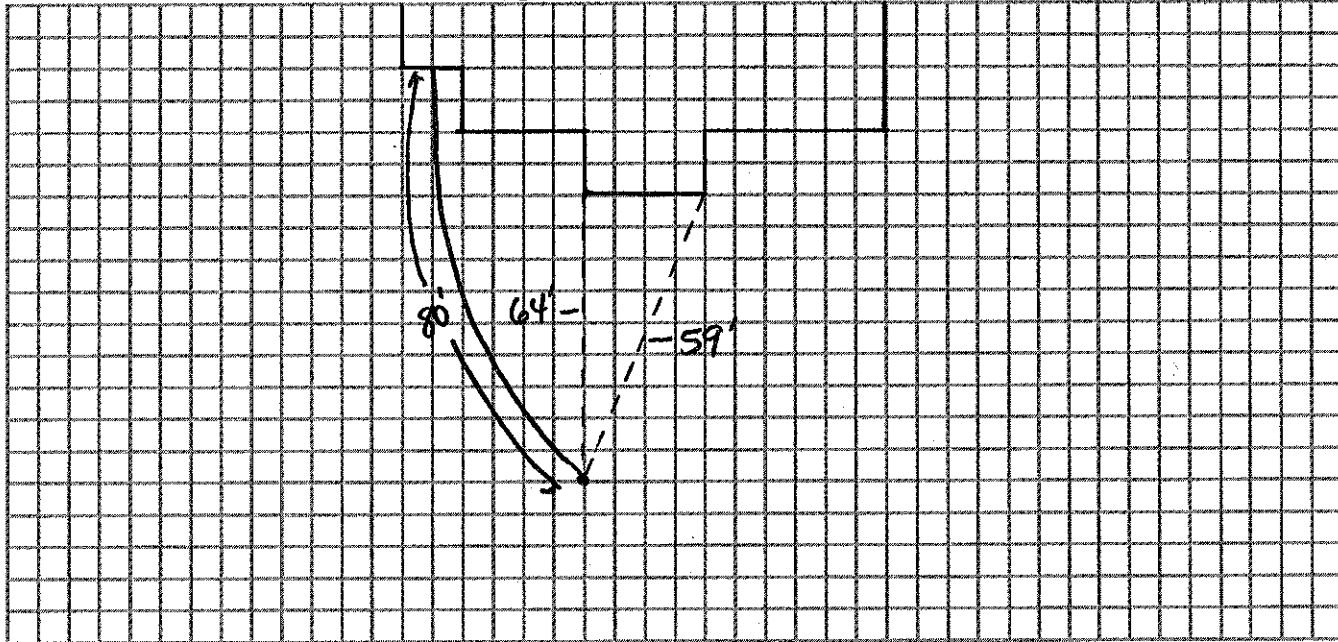

Connection made in:

Street.

Work completed:

Remarks: Installed by McLaughlin Inc.