

WATER SERVICE RECORD

Name DeVries Const. Co.

Service No. 50

Address 12 Fairlawn Lane

Location

~~Repair & Renewal~~ - New Service

0
Inv. 3-21-55


Date	Material	Amount	Total	Date	Amount
2/9/55	Labor	1 85		3-2-55	Deposited 35 00
	10% overhead	19	2 04	3-21-55	Refunded (12 46
	15' - 3/4" copper tubing@.35	5 25	15 75		NON CHARGE 22 54
	1 - 3/4" C x 1/2 I.W.H. stop & waste		4 00	2/9/55	Labor 3 14
	1 hr. trucking		75		10' - 3/4" copper tubing@.35 3 50
			22 54		1 - 3/4" C. corp-cock 4 33
	TRENCH DUG BY OWNER:				1 - 3/4" C. curb-cock 4 67
					1 box and rod 3 90
					1 - 1/2 straight tail pc. 50
					1 - 1/2 offset tail pc. 50
					1 hr. trucking 75
					21 29

DATE _____

TOWN OF LEXINGTON — BOARD OF PUBLIC WORKS

WATER DIVISION

Sketch of Service Here

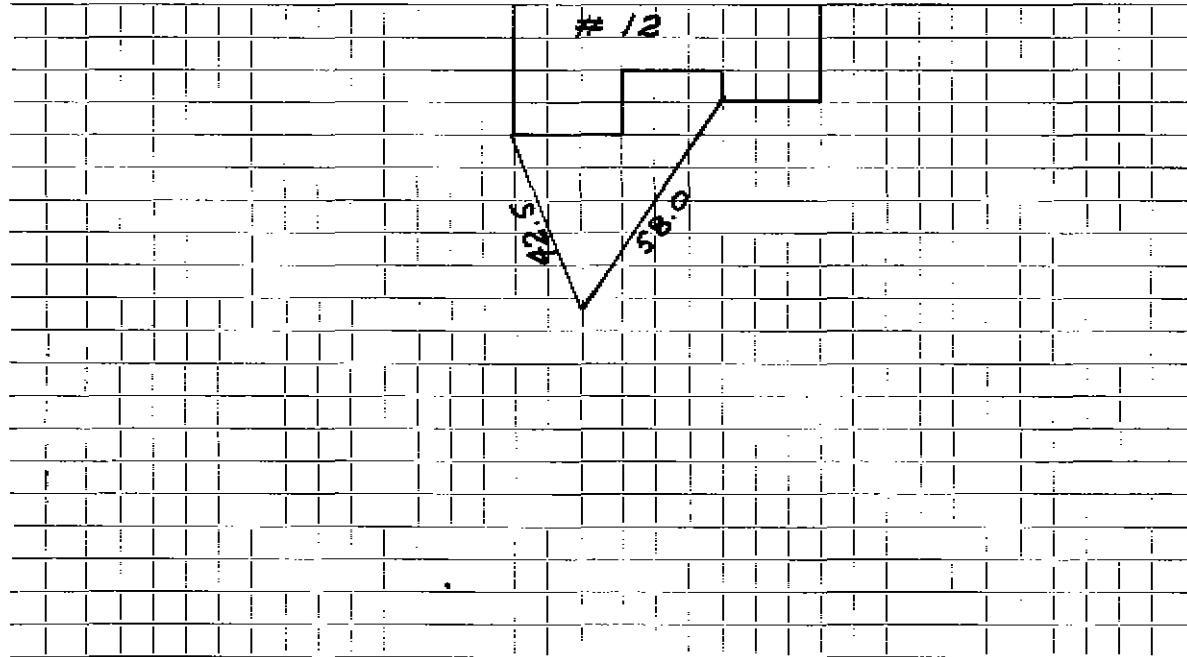

Connection made in Street. Work completed

Remarks:
.....
.....