

WATER SERVICE RECORD

#800

Name DeVries Const. Co., Inc.

Service No. 51

Address 16 Fairlawn Lane

Location

Repair ~~Renewal~~ - New Service

Com. 4-11-55


Date	Material	Amount	Total	Date	Amount
3/10/55	Labor	1 85		3-2-55	Deposited 25 00
	10% overhead	19	2 04	4-11-55	Refunded 10 71
	50' - 3/4" copper tubing @.35	17 50			NOV CHARGE 24 29
	1 - 3/4" C x 3/8 I.W.F. stop & waste	4 00		3/10/55	labor 5 05
	1 hr. trucking		75	10' - 3/4" copper tubing @.35	3 50
			24 29	1 - 3/4" c. corn-cock	4 33
	TRENCH DUG BY OWNER:			1 - 3/4" c. curb-cock	4 67
				1 box and rod	3 90
				1 - straight tail pc.	50
				1 - offset tail pc.	50
				1 hr. trucking	75
					23 20

DATE \_\_\_\_\_

TOWN OF LEXINGTON — BOARD OF PUBLIC WORKS

**WATER DIVISION**

Sketch of Service Here

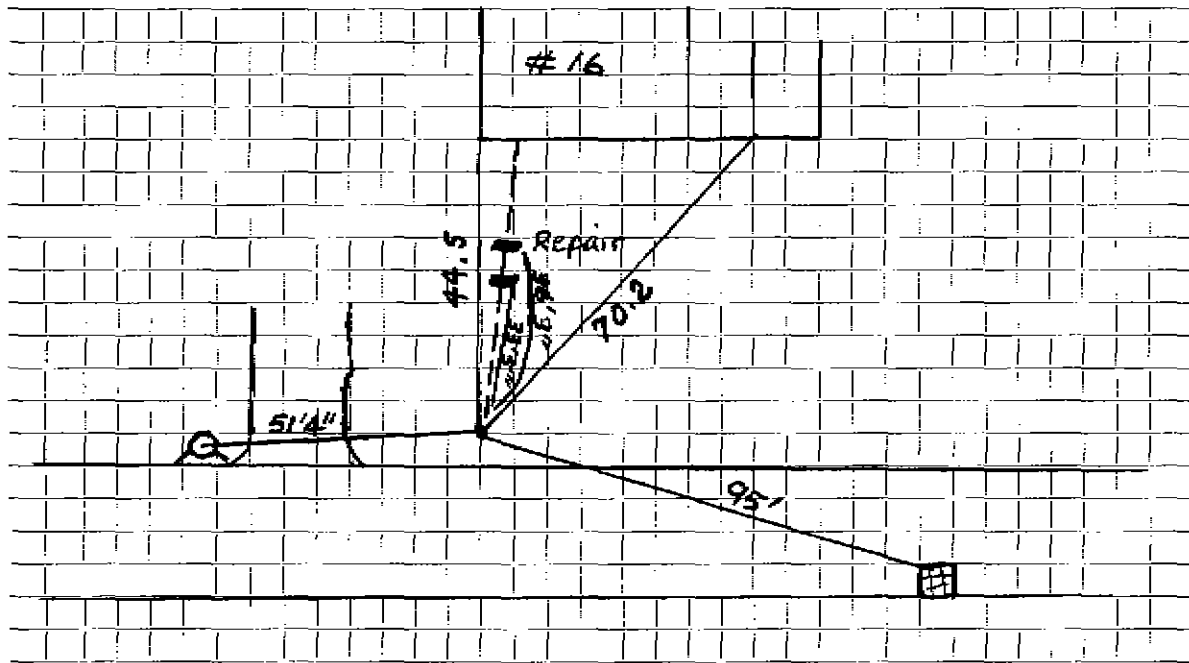

Connection made in ..... Street. Work completed .....

Remarks: .....  
.....  
.....