


DATE 11/13/2020

TOWN OF LEXINGTON — BOARD OF PUBLIC WORKS

WATER DIVISION

Sketch of Service Here

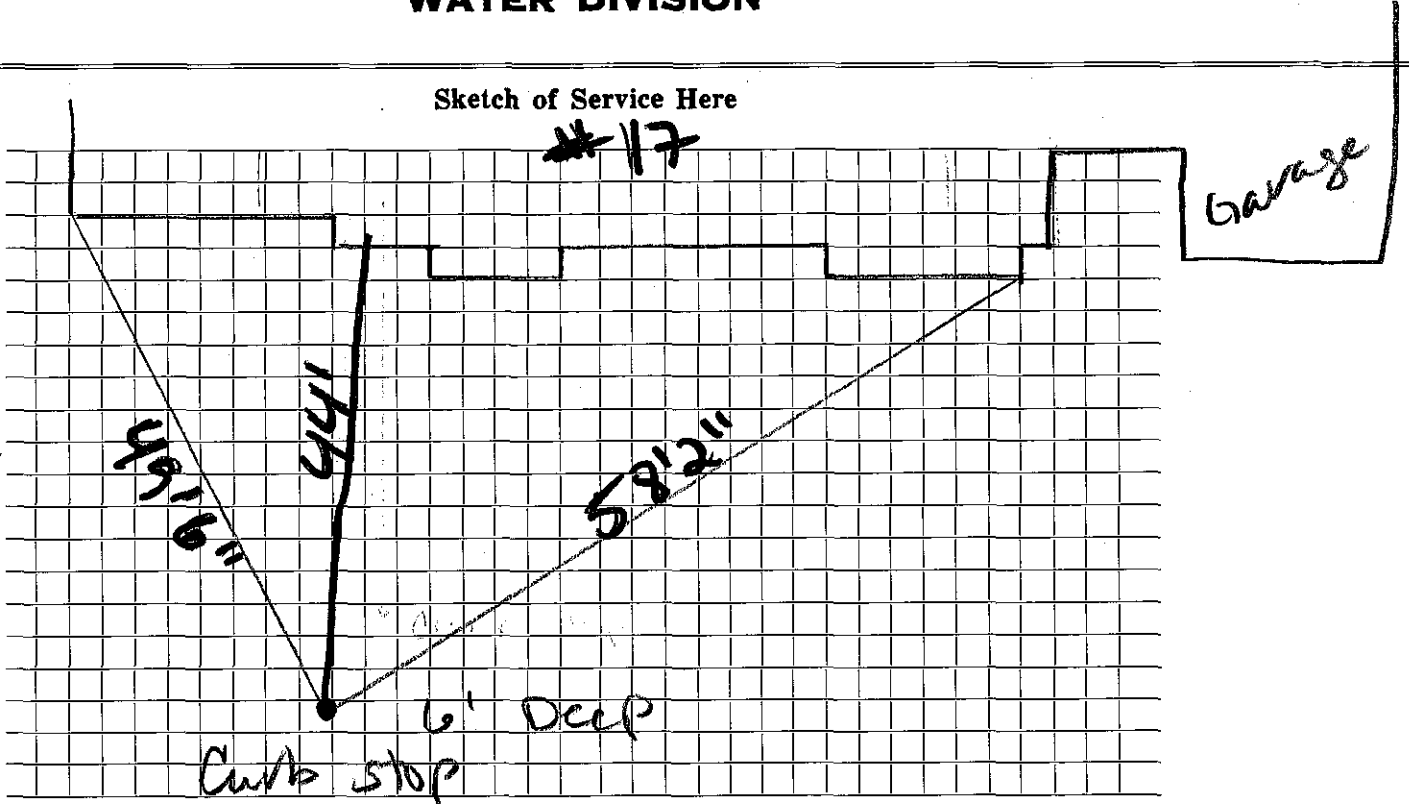

Connection made in ... Fairlawn Ln. Street.

Work completed

Remarks: