

WATER SERVICE RECORD

1008

Name DeVries Const. Co., Inc.

Service No. 53

Address 10 Fairlawn Lane

Location

Repair ~~Renewal~~ New Service

Com. 4-11-55


Date	Material	Amount	Total	Date	Amount
3/10/55	Labor	1 85		3-2-55 Deposited	25 00
	10% overhead	19	2 04	4-11-55 Refunded	(10 71)
	50' - 3/4" copper tubing @ .35	17 50		<u>NON CHARGE</u>	24 29
	1 - 3/4" C x 3/4" I.W.H. stop & waste	4 00		3/10/55 Labor	5 05
	1 hr. trucking		75	10' - 3/4" copper tubing @ .35	3 50
			2 29	1 - 3/4" C. corp-cock	4 33
	TRENCH DUG BY OWNER:			1 - 3/4" C. curb-cock	4 67
				1 box end rod	3 90
				1 - straight tail pc.	50
				1 - offset tail pc.	50
				1 hr. trucking	75
					23 20

DATE _____

TOWN OF LEXINGTON — BOARD OF PUBLIC WORKS

WATER DIVISION

Sketch of Service Here

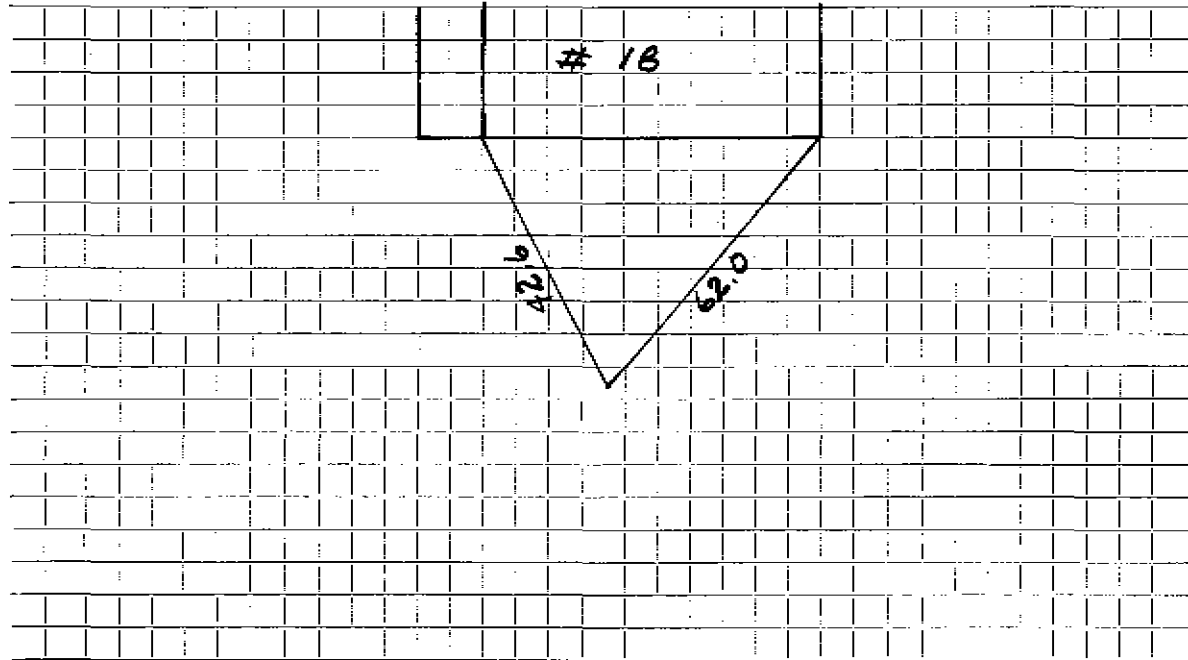

Connection made in Street. Work completed

Remarks:

.....

.....