

WATER SERVICE RECORD

1159

Name DeVries Const. Co., Inc.

Service No. 204

Address 2 Fairlawn ^{Lane} Avenue

Location

~~REPAIR WORK~~ - New Service

Conn 11-79-54

Date	Material	Amount	Total	Date	Amount
9/30/54	Labor	1 85		8-24-54	30 00
	10% overhead	19	2 04	11-29-54	* Refunded (8 16)
	43' - 3/4" copper tubing @	.35	15 05		<u>NON CHARGE</u> 21 84
	1 - 3/4"C x 3/2 I.W.H. stop & waste	4 00		9/30/54	Labor 1 71
	1 hr. trucking		75	7' - 3/4" copper tubing @	.35 2 45
			21 84	1 - 3/4"C. corp-cock	4 33
	TRENCH DUG BY OWNER:			1 - 3/4"C. curb-cock	4 67
				1 box and rod	3 90
				1 - 1/2 straight tail piece	50
				1 - 1/2 offset tail piece	50
				1 hr. trucking	75
					<u>18 81</u>


** This refund made payable to town to apply on w. p.c. #220, #225, #210*

DATE _____

TOWN OF LEXINGTON — BOARD OF PUBLIC WORKS

WATER DIVISION

Sketch of Service Here

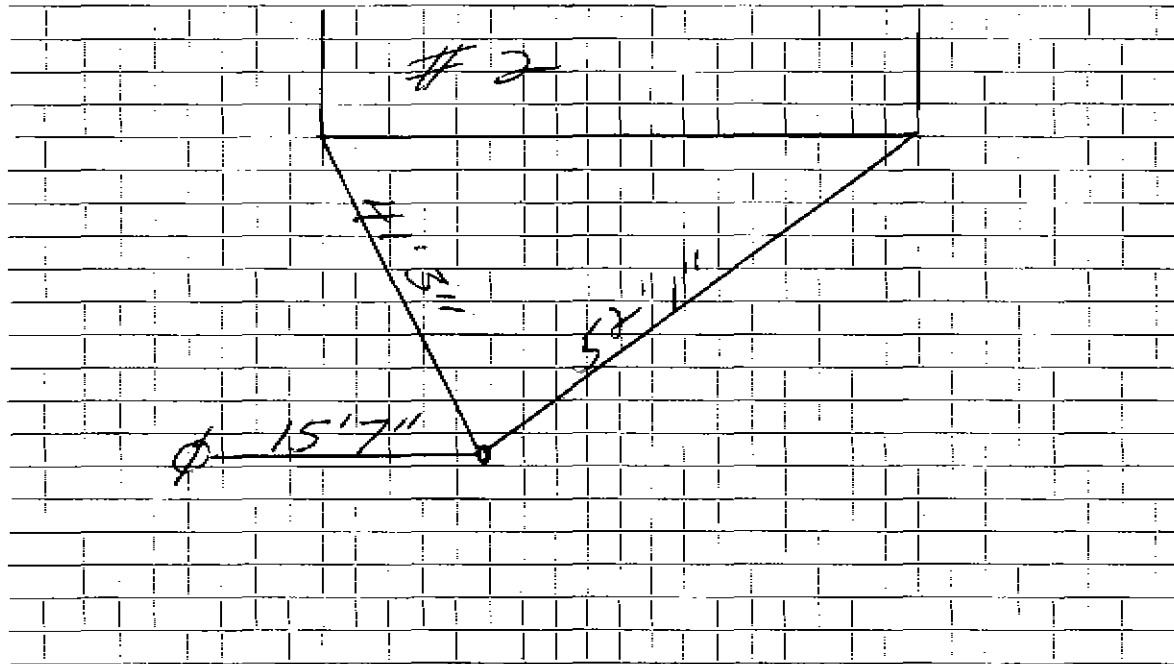

Connection made in Street. Work completed

Remarks:

.....

.....