

## WATER SERVICE RECORD

Name DeVries Construction Co., Inc.

Service No. 421 N.D.

Address 25 Fairlawn Lane

Location

~~Repair/Replace~~ New Service

Com. 12-31-55

Date	Material	Amount	Total	Date	Amount
11/15/55	Labor	1 85			
	10% overhead	19	2 04	8-30-56	6 79
	Owners' copper				NON CHARGE
	1 - 3/4x <sup>1</sup> / <sub>2</sub> I.W.H. Stop & Waste		4 00	Labor	1 85
	1 hr trucking		75	23' 3/4" copper tubing @ .56	12 88
			6 79	1 - 3/4 C. Corp cork	4 33
				1 - 3/4 C. curb cock	4 67
10/19/54	3/4 Comp Curb			1 box & rod	3 90
	3/4 union			1 - <sup>1</sup> / <sub>2</sub> " straight tail piece	50
	4' Copper			1 - <sup>1</sup> / <sub>2</sub> " offset tail piece	50
	Box & Rod				28 63


Amount 1-10-56

DATE \_\_\_\_\_

TOWN OF LEXINGTON — BOARD OF PUBLIC WORKS

WATER DIVISION

Sketch of Service Here

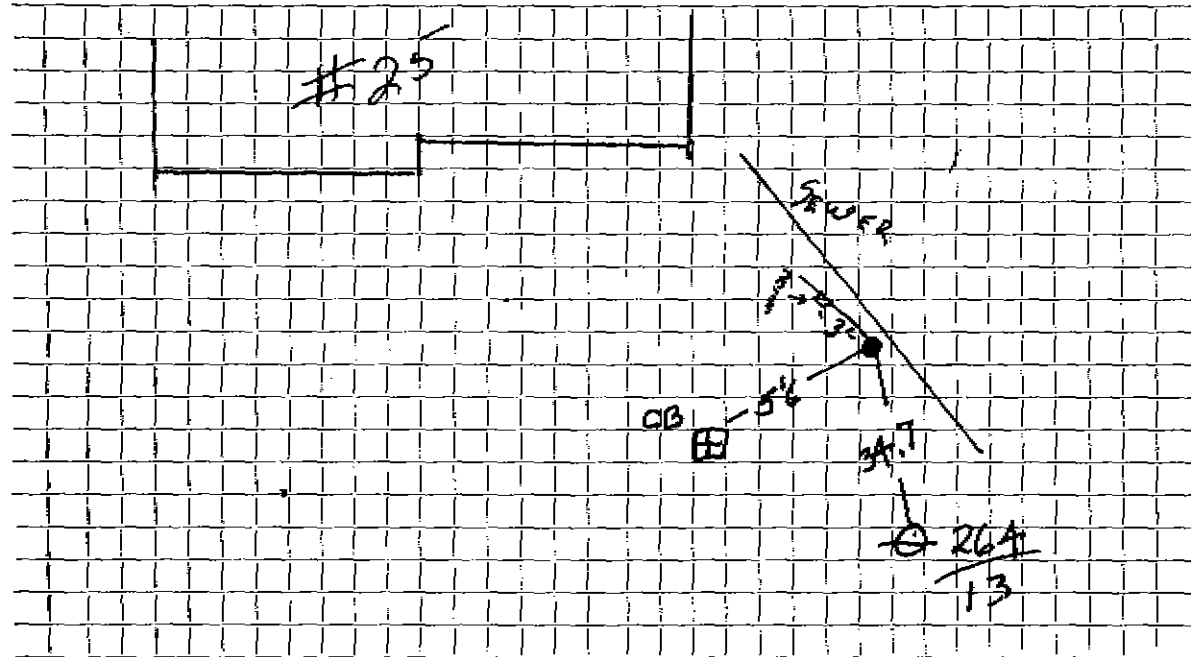

Connection made in ..... Street. Work completed .....

Remarks: SEWER AND WATER IN SAME TRENCH. ABOUT 8' DOWN. CURB HAS BEEN RAISED TO ABOUT 6' DOWN. 10/19/94  
NEW COMPRESSION CURB, 3/4 UNION, 4' COPPER.