

WATER SERVICE RECORD

1207

Name DeVries Construction Co., Inc.

Service No. 424 N.D.

Address 28 Fairlawn Lane

Location

~~Repair-Rework~~ New Service

Cont. 12-31-55

Date	Material	Amount	Total	Date	Amount
11/14/55	Labor	1 85		8-30-56	Paid
	10% overhead	19	2 04		
	Owners' copper				NON CHARGE
	1 - 3/4 C x 1/2 I.W.H. Stop & Waste		4 00		Labor
	1 hr. trucking		75		23' - 3/4" copper tubing @ .56
			6 79		1 - 3/4 C. Corp cock
					1 - 3/4 C. curb cock
					1 box & rod
					1 - 1/2 straight tail piece
					1 - 1/2 offset tail piece
					<u>28 63</u>


Bill sent 1-10-56

DATE _____

TOWN OF LEXINGTON — BOARD OF PUBLIC WORKS

WATER DIVISION

Sketch of Service Here

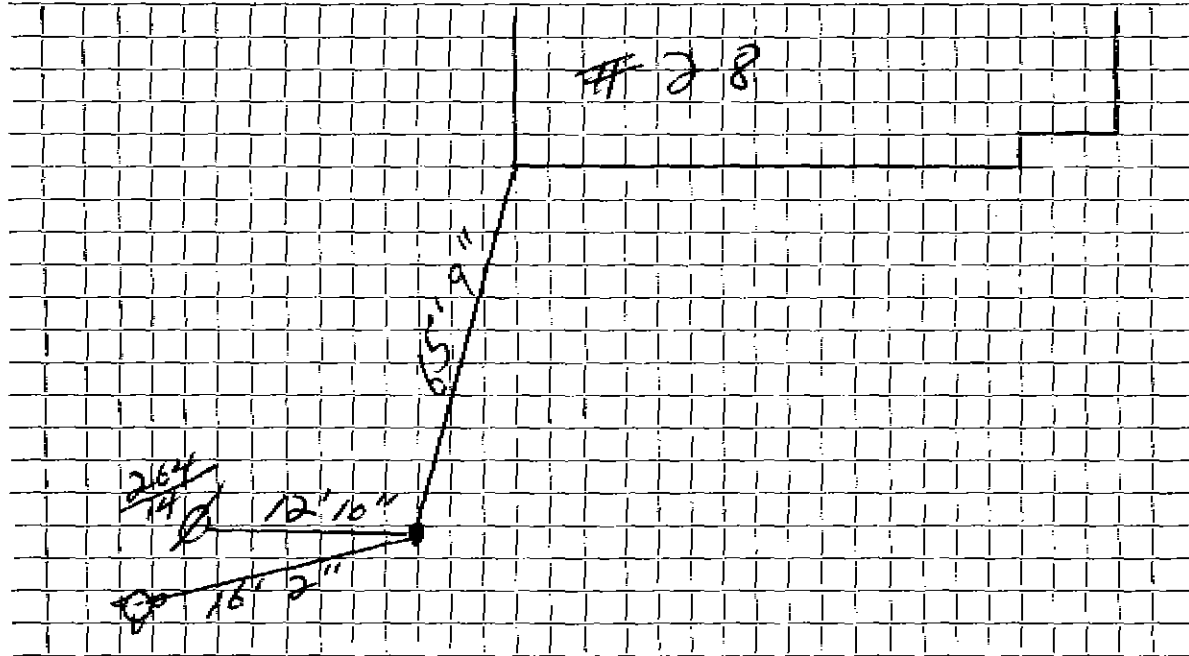

Connection made in Street. Work completed

Remarks:

.....

.....