Name

Service No.

31 Fairlawn Ln Address


Location

Repair - Renewal - New Service							
Date	Material	Amount	Total	Date		Amount	
10/19/21	I" type k copper	100'					
			<u> </u>	<u></u>			
	1" ceurlo stop	_	<u> </u>				
	open right						
	/" ceurb stop open right camb. brass						
			ļ	<u> </u>			
<u> </u>	3/4" tol" coupling						
<u> </u>			 				
	·		ļ				
			ļ				
			<u> </u>				
			<u> </u>			<u> </u>	

Date: 10/19/21

TOWN OF LEXINGTON - BOARD OF PUBLIC WORKS WATER DIVISON

SKETCH OF SERVICE HERE

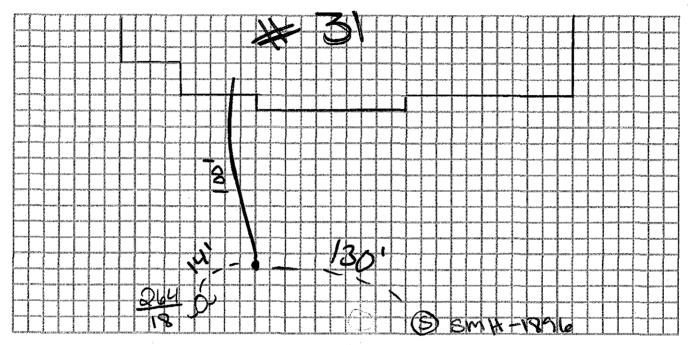

Connection made in:	Fairlawn	Lune	Street.	Work completed:
Remarks:		:		
«Санастольном санастольный пописание озы IIII				