

WATER SERVICE RECORD

#5186  
6688

Name DeVries Const. Co., Inc.

Service No. 223

Address 4 Fairlawn <sup>Lane</sup> Avenue

Location

Repair ~~Renewal~~ New Service

Com 11-29-54


| Date    | Material                           | Amount | Total | Date     |                             | Amount |
|---------|------------------------------------|--------|-------|----------|-----------------------------|--------|
| 9/30/54 | Labor                              | 1 85   |       | 8-24-54  | Deposited                   | 30 00  |
|         | 10% overhead                       | 19     | 2 04  | 11-29-54 | Paid                        | 1 91   |
|         | 110' - 3/4" copper tubing@.35      |        | 38 50 | "        | "                           | 6 26   |
|         | 1 - 3/4"C x 1/2 I.W.H. stop& waste | 4 00   |       |          | NON CHARGE                  | 5 71   |
|         | 1 - 3/4"C. union                   | 1 72   |       | 9/30/54  | Labor                       | 1 71   |
|         | 1 - hr. trucking                   |        | 75    |          | 7' - 3/4" copper tubing@.35 | 2 45   |
|         |                                    |        | 47 01 |          | 1 - 3/4"C. corp-cock        | 4 33   |
|         | TRENCH DUG BY OWNER:               |        |       |          | 1 - 3/4"C. curb-cock        | 4 67   |
|         |                                    |        |       |          | 1 box and rod               | 3 90   |
|         |                                    |        |       |          | 1 - 1/2 straight tail piece | 50     |
|         |                                    |        |       |          | 1 - 1/2 offset tail piece   | 50     |
|         |                                    |        |       |          | 1 hr. trucking              | 75     |
|         |                                    |        |       |          |                             | 18 81  |
|         |                                    |        |       | 2-18-54  | Joint Leak                  |        |

DATE \_\_\_\_\_

TOWN OF LEXINGTON — BOARD OF PUBLIC WORKS

WATER DIVISION

Sketch of Service Here

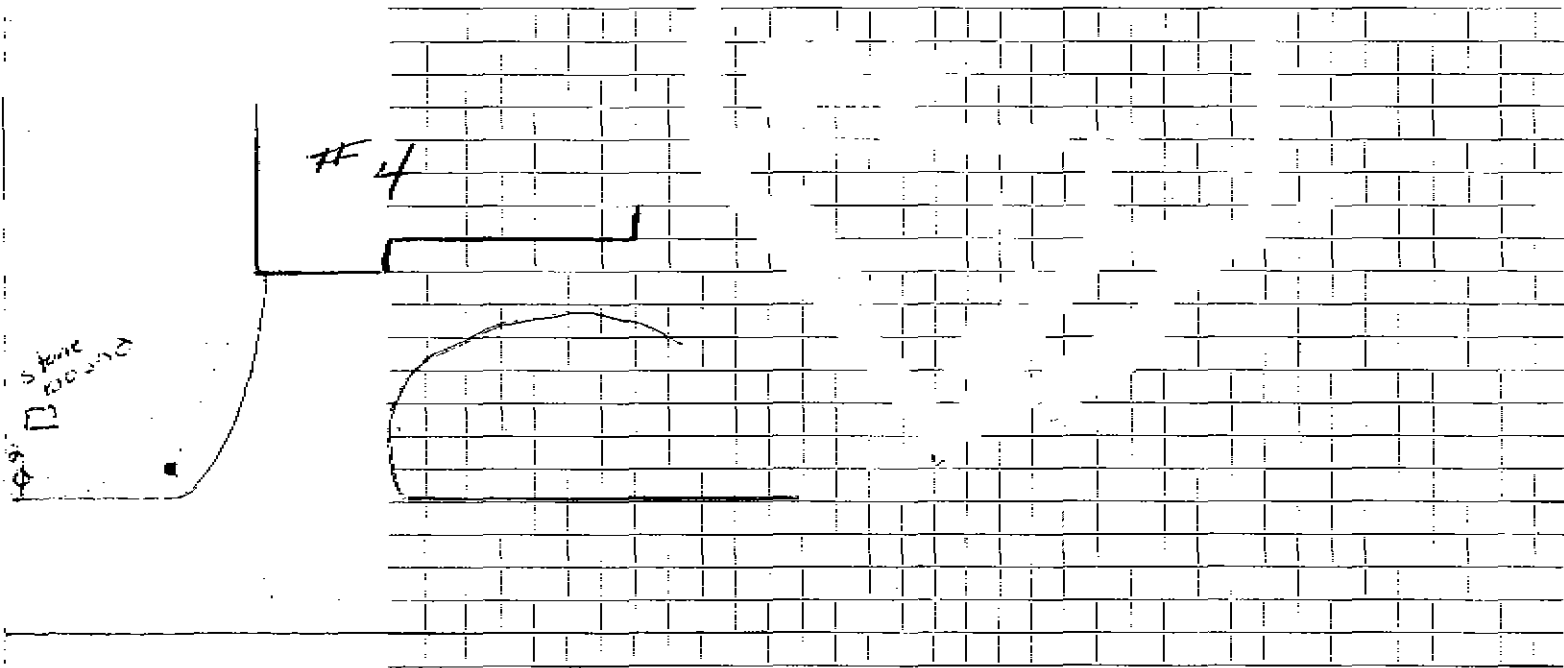

Connection made in     φ 2 1/2"     Street. Work completed .....

Remarks: .....

.....

.....