

WATER SERVICE RECORD

#1949

Name DeVries Const. Co., Inc.

Service No. 225

Address 8 Fairlawn ^{Lane} ~~Avenue~~

Location

~~Repair~~ ~~Renewal~~ New Service

Com 11-29-54


Date	Material	Amount	Total	Date	Amount
9/28/54	Labor	1 85		8-24-54	Deposited 30 00
	10% overhead	19	2 04	11-29-54	Paid 1 28
	65' - 3/4" copper tubing@ .35	.35	22 75		<u>31 26</u>
	1 - 3/4" C x 1/2 I.W.H. stop & waste	.40	4 00	9/28/54	Labor 1 13
	1 - 3/4" C union		1 72		7' - 3/4" copper tubing@ .35 2 45
	1 hr. trucking		75		1 - 3/4" C. corp-cock 4 33
			<u>31 26</u>		1 - 3/4" C. curb-cock 4 67
	TRENCH DUG BY OWNER:				1 box and rod 3 90
					1 - 1/2 straight tail piece 50
					1 - 1/2 offset tail piece 50
					1 hr. trucking 75
					<u>18 23</u>

DATE _____

TOWN OF LEXINGTON — BOARD OF PUBLIC WORKS

WATER DIVISION

Sketch of Service Here

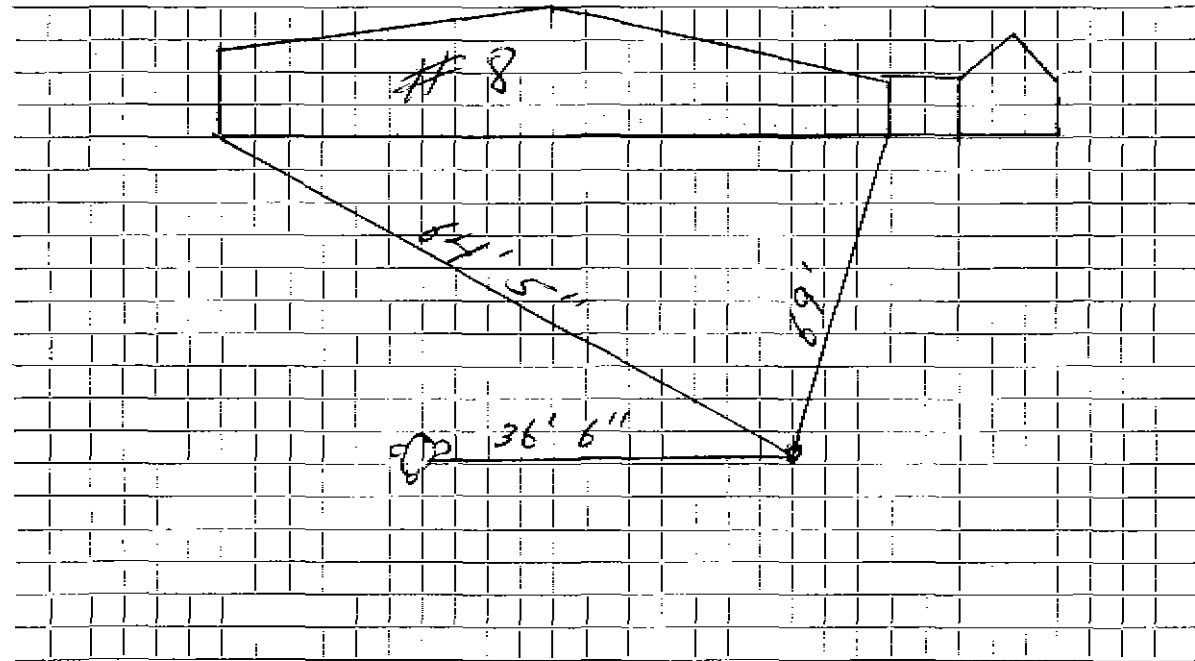

Connection made in Street. Work completed

Remarks:
.....
.....