

WATER SERVICE RECORD

Name Donald Mahoney

Service No. 103

Address 7 Fair Oaks Drive

Location

Repair ~~Renewal~~ - New Service

Com. 9-14-53


Date	Material	Amount	Total	Date	Amount
8/6/53	Labor	1 75		3-18-53	Deposited 25 00
	10% overhead	18	1 93	9-14-53	Paid (10 71)
	80' - 3/4" copper tubing @ .3629	29 03			<u>NON CHARGE</u> 35 71
	1 - 3/4" C x 1/2 I.W.R. stop & waste	4 00		8/6/53	Labor 1 75
	1 hr. trucking	75			13' - 3/4" copper tubing @ .3629 4 72
			35 71		1 - 3/4" C. corp-cock 4 33
					1 - 3/4" C x 3/4" C curb-cock 4 67
					1 box and rod 3 90
					1 - 1/2 straight tail pc. 50
					1 - 1/2 offset tail pc. 50
					1 hr. trucking 75
					DEM 21 12
				NOV-02 10'	1" Copper
					1" Corp
					1" Curb
					1X 3/4 Red
					Buff 10 box

DATE _____

TOWN OF LEXINGTON — BOARD OF PUBLIC WORKS

WATER DIVISION

Sketch of Service Here

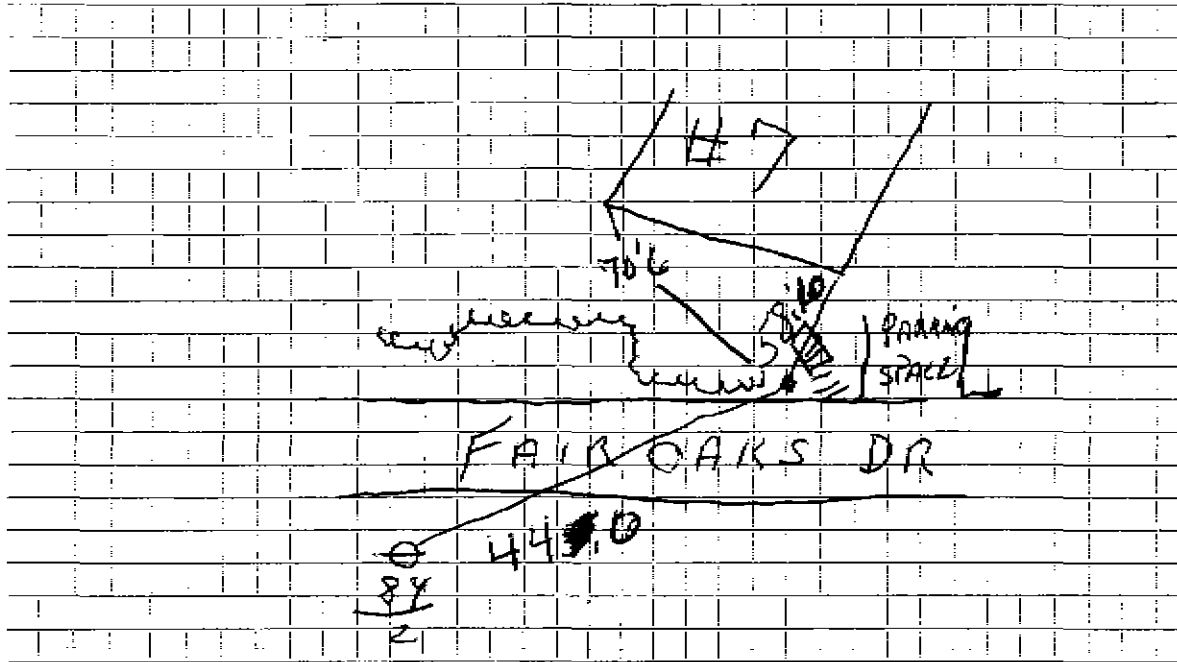

Connection made in Street. Work completed 2002

Remarks:
.....
.....