

WATER SERVICE RECORD

# 4786

Name James Garten

Service No. 159

Address 17 Fairview Avenue

Location

Repair - ~~Renewal~~ - New Service

*Com 830-54*

Date	Material	Amount	Total	Date	Amount
7/10/54	Labor	1 85		7-6-54	25 00
	10% overhead	19	2 04	12-20-54	2 79
	60' - 3/4" conper tubing@.35	21 00			<u>27 79</u>
	1 - 3/4" C x 1/2 I.W.H. stop & waste	4 00			<u>NON CHARGE</u>
	1 hr. trucking	75	27 79	7/10/54	Labor
	TRENCH DUG BY OWNER:				12' - 3/4" copper tubing@.35
					1 - 3/4" C. corp-cock
					1 - 3/4" C x 3/4" C. curb-cock
					1 box and rod
					1 - 1/2 straight tail pc.
					1 - 1/2 offset tail pc.
					1 hr. town shovel
					1 hr. trucking
					<u>75</u>
					38 53


*8-30-54*

DATE \_\_\_\_\_

TOWN OF LEXINGTON — BOARD OF PUBLIC WORKS

WATER DIVISION

Sketch of Service Here

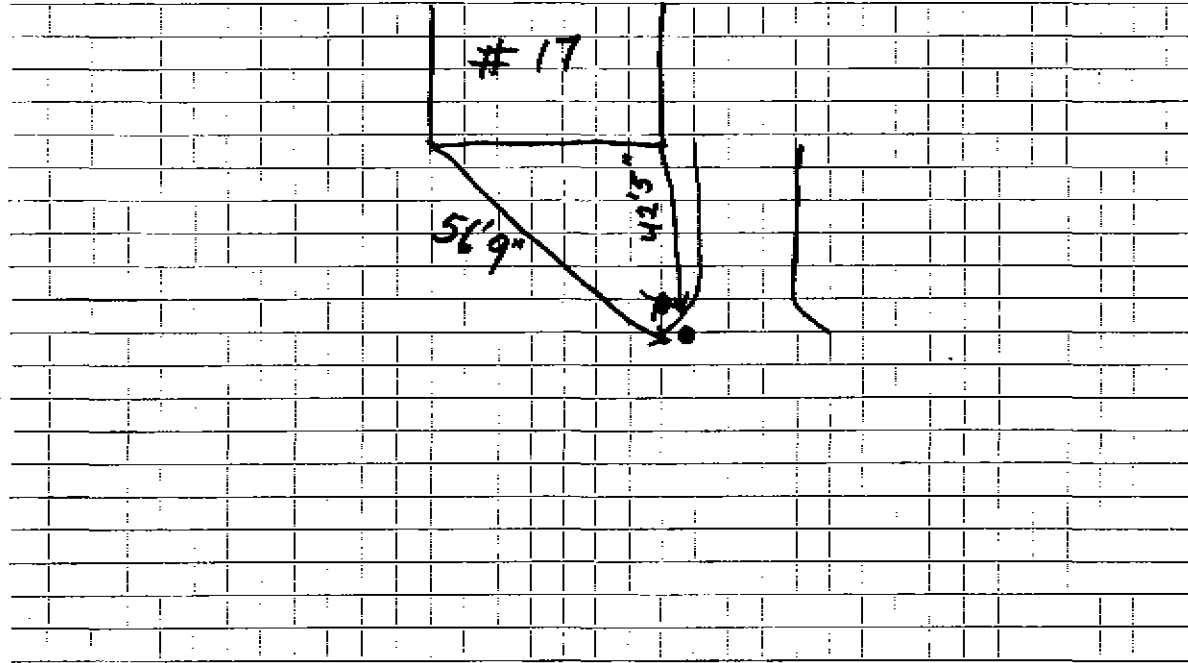

Connection made in ..... Street. Work completed .....

Remarks: .....

.....

.....