


DATE _____

TOWN OF LEXINGTON — BOARD OF PUBLIC WORKS

WATER DIVISION

Sketch of Service Here

LOT #2

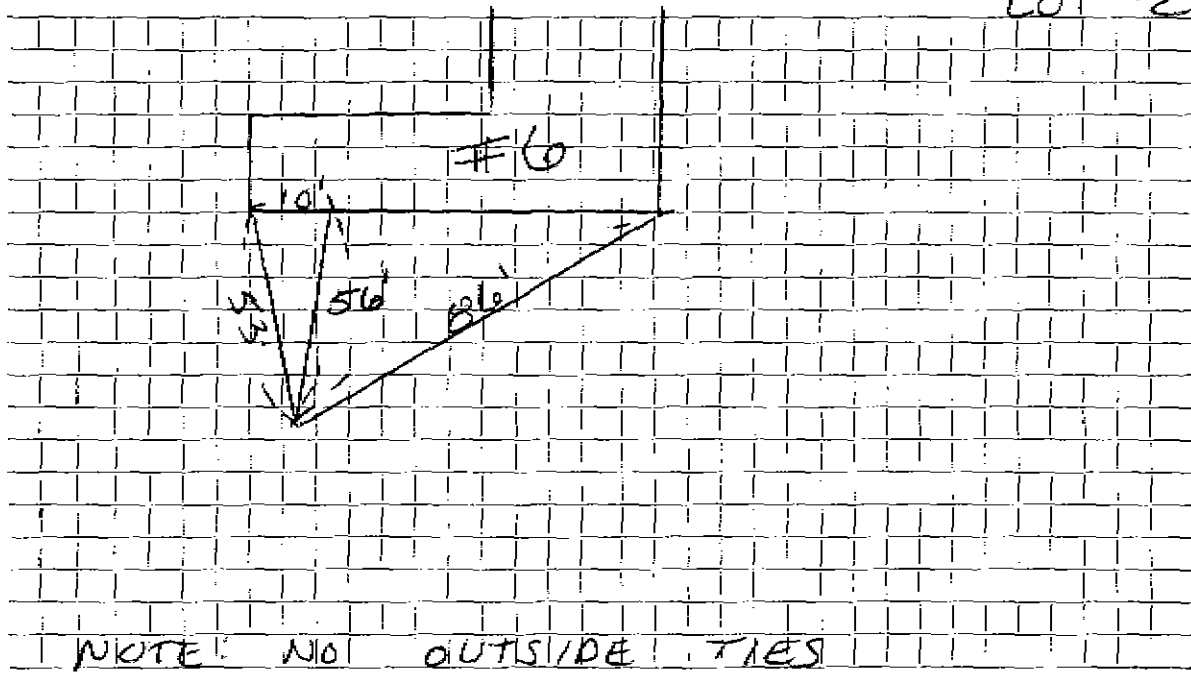

Connection made in FARM RD Street. Work completed

Remarks:
.....
.....