

WATER SERVICE RECORD

1288

Name Andrew W. Rennee

Service No. 90

Address 10 Farmcrest Avenue

Location Lexington, Mass.

~~REPAIRS~~ - New Service Com. 5-21-51


Date	Material	Amount	Total	Date	Material	Amount
2/26/51	Labor	1 35	1 35	July 1951	Start	18 54
	10% overhead		14			
	35' -3/4" copper tubing @ .36	12 60	12 60		No Charge	
	1 -3/4" Cx1/2" I.W.H. S&W	4 00	4 00	2/26/51	Labor	4 05
	1 hr. trucking		75		30' -3/4" copper tubing @ .36	10 80
			18 84		1 -3/4" C corp-cock	4 33
					1 - 3/4" C x 3/4" c. curb-cock	4 67
					1 - box and rod	4 68
					1 - 1/2 offset tail piece	50
					1 - 1/2 straight tail piece	50
					1 hr. trucking	75
					patching 25 x 3	25 00
						55 28
				9-16-92	Broken by GAS CO.	
					3' 3/4 COPPER	
					2 COMP UNIONS	

DATE _____

TOWN OF LEXINGTON — BOARD OF PUBLIC WORKS

WATER DIVISION

Sketch of Service Here

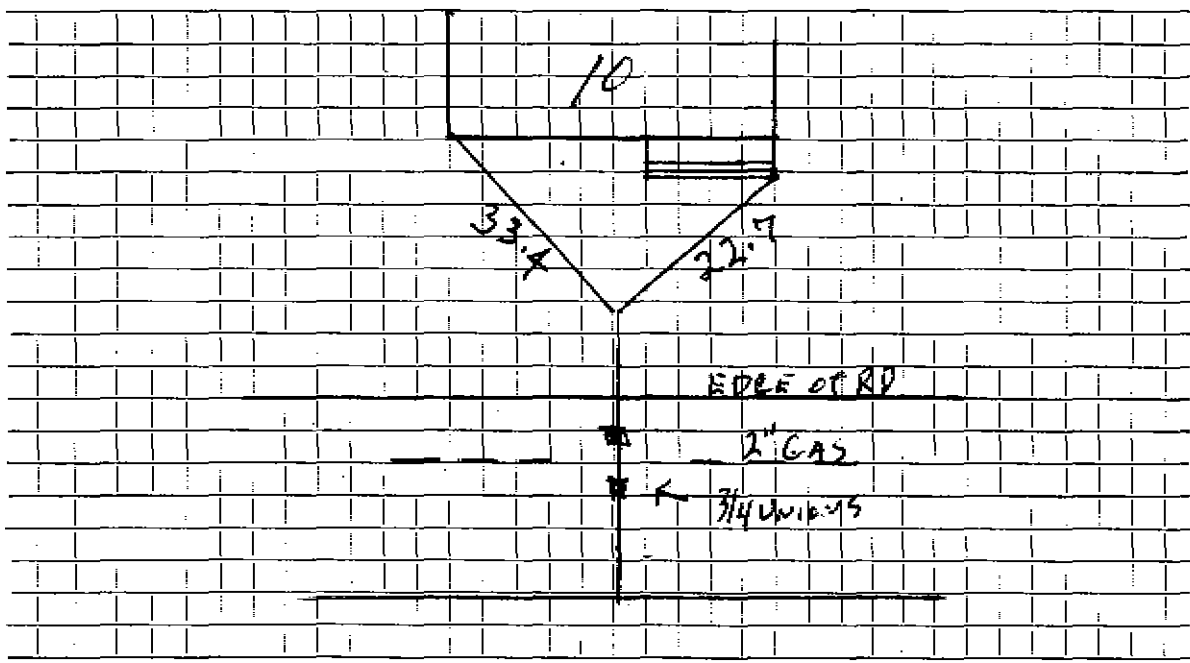

Connection made in Street. Work completed

Remarks:
.....
.....