

1433

Name Joseph Pecararo

Service No. 242

Address 12 Farmcrest Avenue  
Lexington, Mass.

Location 12 Farmcrest Avenue

Kind of Pipe

Size

Size of Main

~~Repair~~ ~~Renewal~~ ~~XXXXXX~~ ~~XXXXXX~~ New Service

Com. 12-5-49

Location

Date	Material	Amount	Total	Date	Amount
Nov. 23, '49	Labor	4 40	4 40	Nov. 10 '49	60 00
	10% Overhead		44	Dec. 22 '49	55 73
	40' - 3/4" Copper Tubing @ .24	9 60			
	1 - 3/4" C x 3/8" I.W.H. S&W	3 15		Nov. 23, '49	4 40
	1 - 3/4" C x 3/4" C Union (3pts)	1 39		27' - 3/4" Copper Tubing @ .24	6 48
	Littlefield Shovel 2 hrs. @ 7.00	14 00		1 - 3/4" Corp-cock	3 15
	Trucking 1 hr. @ .75	75		1 - 3/4" C x 3/4" C Curb-cock	3 85
	Patching 22 x 3		22 00	1 - Box & Rod	3 75
			55 73	1 - 1/2" Offset Tail Piece	37
				1 - 1/2" Straight Tail Piece	37
				Littlefield Shovel 1 1/2 hrs. @ 7.00	10 50
				Trucking 1 hr. @ .75	75
	<b>Labor</b>				33 62

Deposited  
Refunded  
no charge

TOWN OF LEXINGTON - BOARD OF PUBLIC WORKS  
**WATER DIVISION**

The undersigned applies for a supply of water at No..... St. and hereby agrees to comply with the rules and regulations as now, or at any future time, established by the Board of Selectmen.

Am't of Estimate \$.....


Owner .....

Am't Paid \$.....

Address .....

Builder .....

Sketch of Service Here

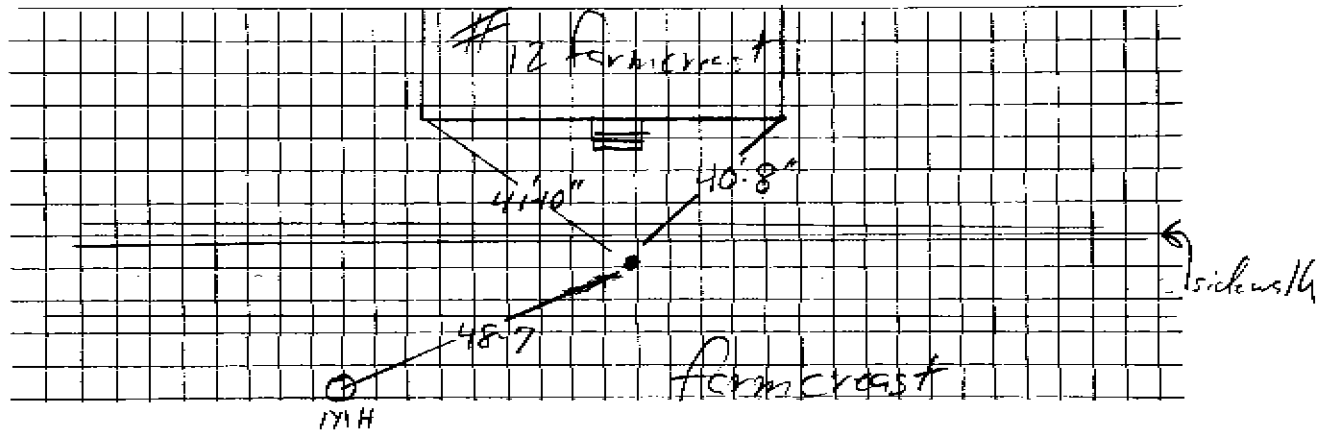

Connection made in ..... Street.

Work completed .....19

Remarks: