

WATER SERVICE RECORD

Name R. B. Hackenberger

Service No. 318

Address 17 Farmorent Avenue

Location

~~Repair~~—~~Renewal~~—~~New Service~~

Com. 11-9-53

Date	Material	Amount	Total	Date	Amount	
10/7/53	Labor	1 90		10-5-53	25 00	
	10% Overhead	19	2 09	11-9-53	7 28	
	30' - 3/4" Copper tubing @ .3629	10 88			17 72	
	1 - 3/4" C x 3/4" I.W. H. stop & waste	4 00				
	1 hr. trucking		75	10/7/53	Labor	1 90
			17 72			
				10' - 3/4" Copper tubing @ .3629	3 63	
				1 - 3/4" C. corp-cock	4 33	
				1 - 3/4" C. x 3/4" C. curb-cock	4 67	
				1 box and rod	3 90	
				1 - 3/4" straight tail piece	50	
				1 - 3/4" offset tail piece	50	
				1 hr. trucking	75	
					20 18	


Deposited
Refunded
NON CHARGE

DATE _____

TOWN OF LEXINGTON — BOARD OF PUBLIC WORKS

WATER DIVISION

Sketch of Service Here

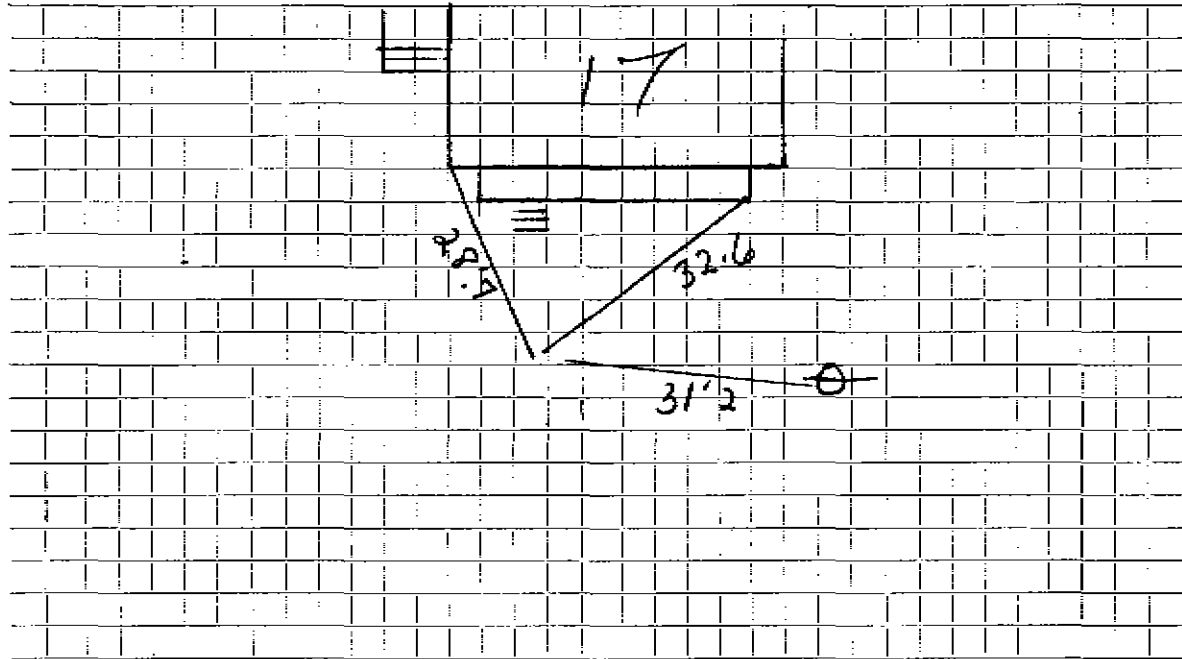

Connection made in Street. Work completed

Remarks:
.....
.....