

WATER SERVICE RECORD

Name Roy Fountain

Service No. 267

Address 24 Farmcrest Avenue, Lexington

Location

Repair ~~Renewal~~ - New Service

Com. 11-21-55


Date	Material	Amount	Total	Date	Amount
8/25/55	Labor	1 85		8-16-55	Deposited 20 00
	10% Overhead	19	2 04	11-21-55	Refunded (11 69
	30'-3/4" Copper tubing @ .384	11 52			Non Charge 18 31
	1-3/4" Cx 1/2" I.W.F. stop & waste	4 00		8/25/55	Labor 1 85
	1 hr. trucking @ .75		75	28'-3/4" Copper tubing @ .384	10 75
			16 31	1-3/4" C Corp cock	4 33
				1-3/4" Cx 3/4" C Curb cock	4 87
				1 Box & Rod	3 90
				1-1/2" straight tail piece	50
				1-1/2" offset tail piece	50
					26 50

DATE _____

TOWN OF LEXINGTON — BOARD OF PUBLIC WORKS

WATER DIVISION

Sketch of Service Here

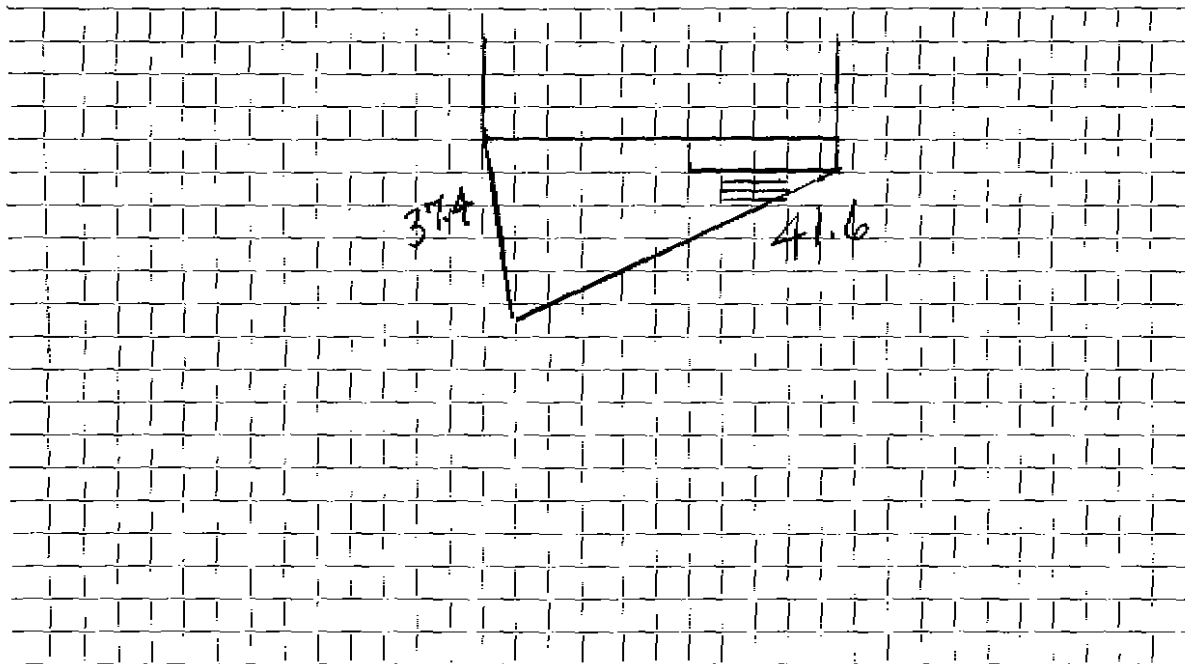

Connection made in Street. Work completed

Remarks:

.....

.....