

Name Patrick F. Malloy
 Address Lot #71, Farmcrest Ave.

Service No. #838

Location

Kind of Pipe Size Size of Main

~~Repair~~ - ~~Renewal~~ - New Service

Location

Bradley Press, Inc., Lexington

Date	Material	Amount	Total	Date	Amount
	33' 1" O.L. Pipe @ .27	8 91			
	2 1" L.L. Ells @ .35	70			
	3 1" L.L. Coup. @ .30	90			
	2 1" Br. Sp. Nip. @ .25	50			
	1 S & W	3 00			
	Trucking	75	14 76		
9/14/29	7 Hrs. Labor @ .65	3 85			
	2 " " @ .60	1 20	5 05		
	15% Overhead		76		
			20 57		
	Labor				

Sept. 5 1929 - Cash
 Oct. 28 1929 - Cash

17
 3 57

dig own trench

DATE Sept. 5, 1929

TOWN OF LEXINGTON - BOARD OF PUBLIC WORKS

WATER DIVISION

The undersigned applies for a supply of water at No. ^{Lot #25} 71, Farmcrest Ave St. and hereby agrees to comply with the rules and regulations as now, or at any future time, established by the Board of Selectmen.

Am't. of Estimate \$ 1


Owner Patrick J Malloy

Am't. Paid \$ 17 9-5-29

Address Farmcrest Avenue
Town

Builder _____

Sketch of Service Here

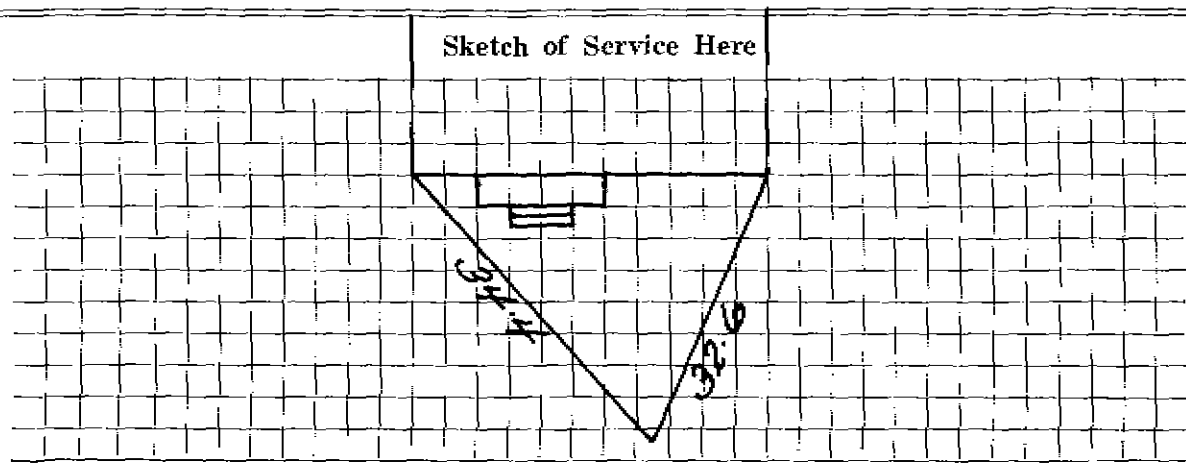

Connection made in _____ Street.

Work completed _____ 19

Remarks: