

WATER SERVICE RECORD

Name Edward C. Mann

Service No. 58

Address 26 Farmcrest Avenue

#2079

Location

~~Repair - Renewal~~ New Service

Comm 8-4-58


Date	Material	Amount	Total	Date		Amount
5-28-58	Labor	3.70		4-30-58	Deposit	50.00
	10% overhead	.37	4.07	8-4-58	Refund	<u>26.16</u>
38'	3/4" Copper tubing @.70		14.06			23.84
1	3/4" Cx 1/2 I.W.H. Stop & Waste		4.96		NON CHARGE	
1	hr. Trucking @ .75		.75		Labor	3.70
			<u>23.84</u>	26'	3/4" Copper tubing @.37	9.62
				1	3/4" C Corp Cock	4.64
				1	3/4" C Curb Cock	6.03
				1	Box & Rod	5.00
				1	1/2 Straight tail piece	.50
				1	1/2 Offset tail piece	.50
				16	x 3 Patch	16.00
				1/8	hr. Town Shovel @ 6.50	<u>3.25</u>
						49.24

TOWN OF LEXINGTON — BOARD OF PUBLIC WORKS

WATER DIVISION

DATE _____

Sketch of Service Here

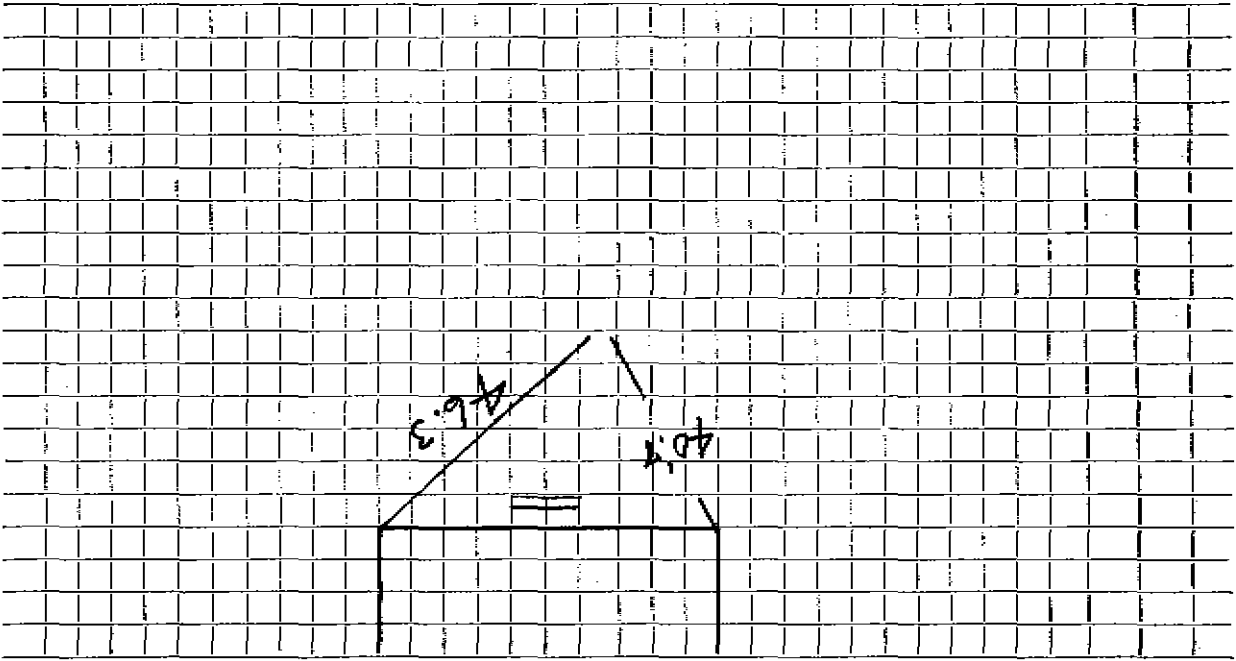

Connection made in _____
Street _____
Work completed _____
Remarks: _____