

WATER SERVICE RECORD

Name Edward Bentsen

Service No. 41

Address 27 Farmcrest Avenue

Location Lexington, Mass.

~~Repair~~ Renewal ~~New Service~~


Com. 5-21-51

Date	Material	Amount	Total	Date	Material	Amount
4-11-51	Labor	1 65	1 65	March 51	Installed	20 30
	10% Overhead		17			1 62
	34' - 3/4" Copper Tubing @.36	12 24			No Charge	18 81
	1 - 3/4"C x 1/2" I.W.H. S&W	4 00	4 00	4-11-51	Labor	4 95
	Trucking 1 hr. @.75		75		10' - 3/4" Copper Tubing @.36	3 60
			18 81		1 - 3/4"C Corp-cock	4 33
					1 - 3/4"C x 3/4"C Curb-cock	4 67
					1 - Box & Rod	4 68
					1 - 1/2" Straight Tail Pieces	50
					1 - 1/2" Offset Tail Pieces	50
					Trucking 1 hr. @.75	75
						23 98

DATE _____

TOWN OF LEXINGTON — BOARD OF PUBLIC WORKS
WATER DIVISION

Sketch of Service Here

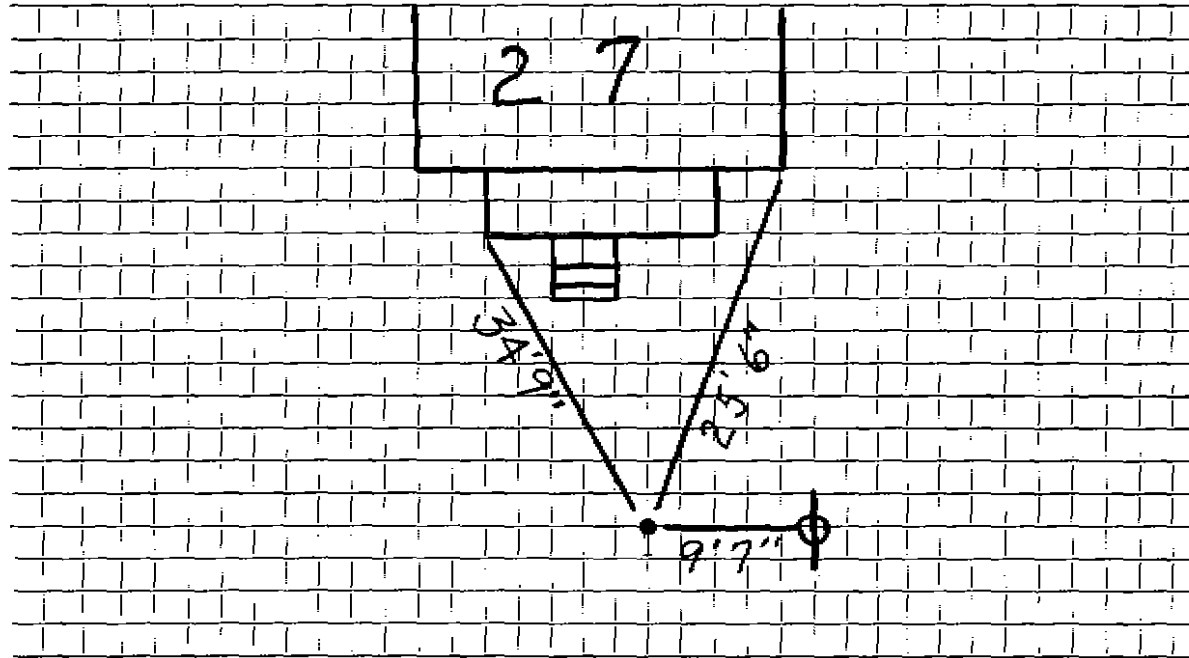

Connection made in Street. Work completed

Remarks:

.....

.....