

WATER SERVICE RECORD

Name Charles J. Martin

Service No. 317

Address 29 Farmcrest Avenue

Location Lexington, Mass.

~~Repair~~ ~~Renewal~~ ~~New Service~~


Com. 12-26-50

Date	Material	Amount	Total	Date	Material	Amount
Oct. 27, '50	Labor	1 35	1 35	Oct 27, '50	Deposited	20 00
	10% Overhead		14			
	41' - 3/4" Copper Tubing @ .32	13 12	13 12		No Charge	19 12
	1 - 3/4" C x 1/2" I.W.H. S&W		3 76	Oct. 27, '50	Labor	1 35
	Trucking 1 hr. @ .75		75		8' - 3/4" Copper Tubing @ .32	2 56
			19 12		1 - 3/4" C Corp-cock	3 60
					1 - 3/4" C x 3/4" C Curb-cock	4 40
					1 - Box & Rod	3 35
					1 - 1/2" Straight Tail Piece	42
					Trucking 1 hr. @ .75	75
						16 43

DATE _____

TOWN OF LEXINGTON — BOARD OF PUBLIC WORKS
WATER DIVISION

Sketch of Service Here

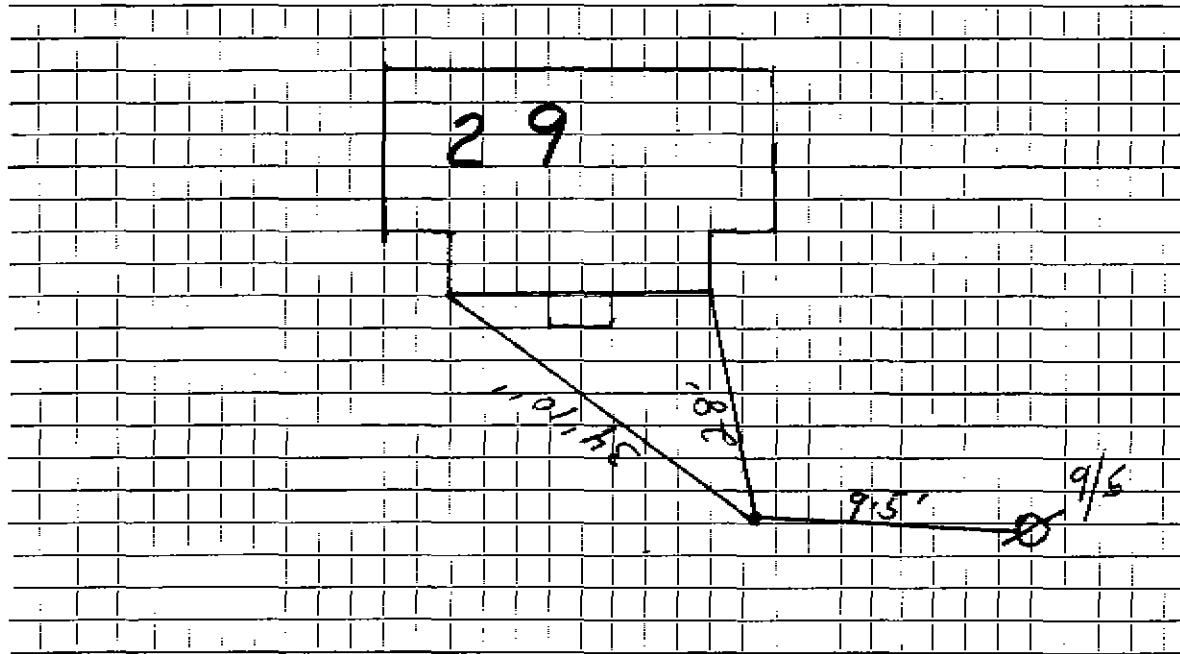

Connection made in Street. Work completed

Remarks:

.....
.....