

WATER SERVICE RECORD

Name W. L. Mussum

Service No. 97

Address 30 Ferncrest Ave.

Location Lexington, Mass


Repair—Renewal—~~NEW SERVICE~~ *Sum. 9-24-51*

Date	Material	Amount	Total	Date	Amount
6/18/51	Labor	1 49	1 49	5-21-51	20 00
	10% overhead		15	9-24-51	1 15
	40' - 3/4" copper tubing @ .326	13 04			No Charge
	1 - 3/4" C x 1/2 T.W.H. stop & waste		4 00	6/13/51	Labor
	1 - 3/4" C x 3/4" union (3pts.)		1 72		50' - 3/4" copper tubing @ .326
	1 hr. trucking		75		1 - 3/4" C. corp-cock
			21 15		1 - 3/4" C x 3/4" C. curb-cock
					1 - box and rod
					1 - 1/2" straight tail piece
					1 - 1/2" offset tail piece
					1 hr. trucking
					patching 8 x 3
					34 70

DATE _____

TOWN OF LEXINGTON — BOARD OF PUBLIC WORKS
WATER DIVISION

Sketch of Service Here

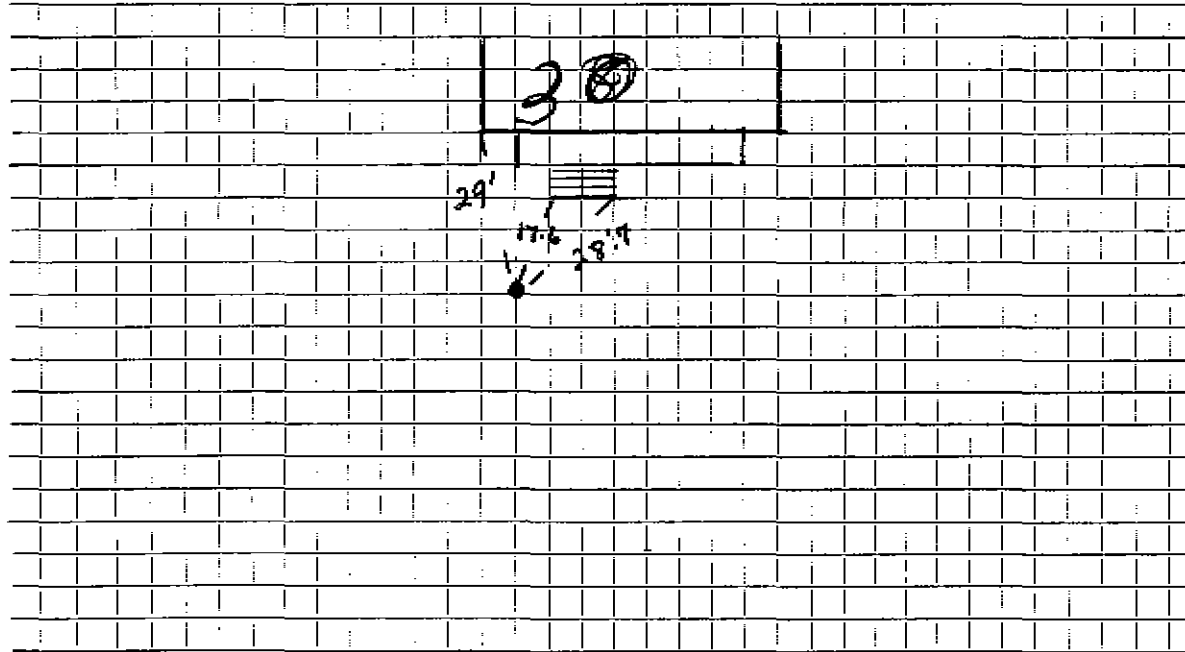

Connection made in Street. Work completed

Remarks:
.....
.....