

## WATER SERVICE RECORD

Name James Perry

Service No.

7

Address 39 Farmcrest Avenue

Location

~~REPAIR~~—Renewal—~~New Service~~ W.O. #7592

JUL 27 1970


Date	Material	Amount	Total	Date	Amount	
5-7-70	Labor	27.70		4-21-70	Deposit	210.00
	10% O.H.	2.77	30.47	7-27-70	Refund	124.85
45'	3/4" Copper tubing @.79		35.55			85.15
1	3/4" W.H. Stop & Waste		11.13		OUTSIDE	
1	hr. Town Shovel @6.50		6.50	5-7-70	Labor	41.55
1/2	hr. Trucking @3.00		1.50	1	3/4" Curb Cock	11.32
			85.15	1	Box & Rod	5.10
				1	hr. Town Shovel @6.50	6.50
				1/2	hr. Trucking @3.00	1.50
				1985	4.5' 1" Copper	65.97
					1" Corp	
					3/4" x 1" Reducer	
				6'	3/4" Copper	

DATE

TOWN OF LEXINGTON -- BOARD OF PUBLIC WORKS

WATER DIVISION

Sketch of Service Here

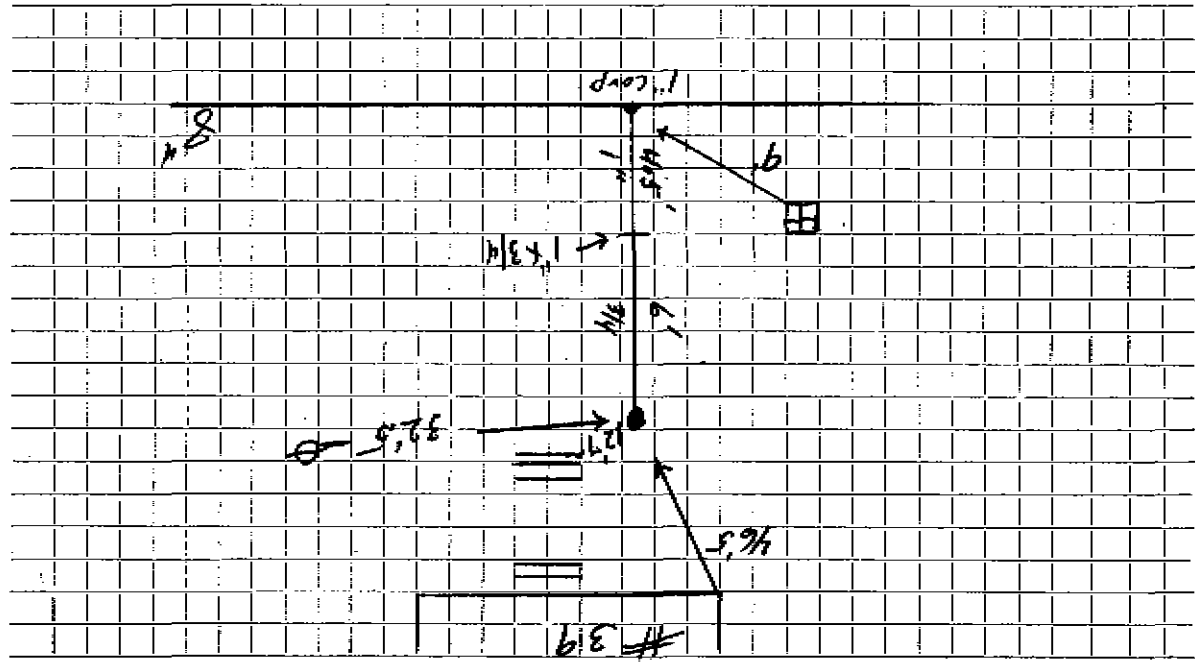

Connection made in Street. Work completed

Remarks: