

WATER SERVICE RECORD

Name William N Reid

Service No. 12

Address 4 Farmcrest Avenue

Location

~~Repair~~—Renewal—~~New Service~~ W O #4381# 7313
7349

JAN 22 1968


Date	Material	Amount	Total	Date	Amount
5/10/67	Labor	47 44			
	10% O.H.	4 74	52 18	4-17-67	Deposit 125 00
	36' 3/4" copper tubing @ .79		28 44	1-22-68	Retrad 17 58
	1 3/4" wheel valve		9 30		107 42
	1 1/2 Hrs. Trucking @ 3.00		4 50		
	2 Hrs. Shovel @ 6.50		13 00		NON-CHARGE
			107 42	5/10/67	Labor 47.44 ** O.H. 52 18
				27'	3/4" copper tubing @ .79 21 33
				1	3/4" Curb 8 76
				1	3/4" Adaptor 2 76
				1 1/2	Hrs. Trucking @ 3.00 4 50
				2	Hrs. Shovel @ 6.50 13 00
				500	Lbs. cold patch 1 25
					103 78

DATE _____

TOWN OF LEXINGTON — BOARD OF PUBLIC WORKS

WATER DIVISION

Sketch of Service Here

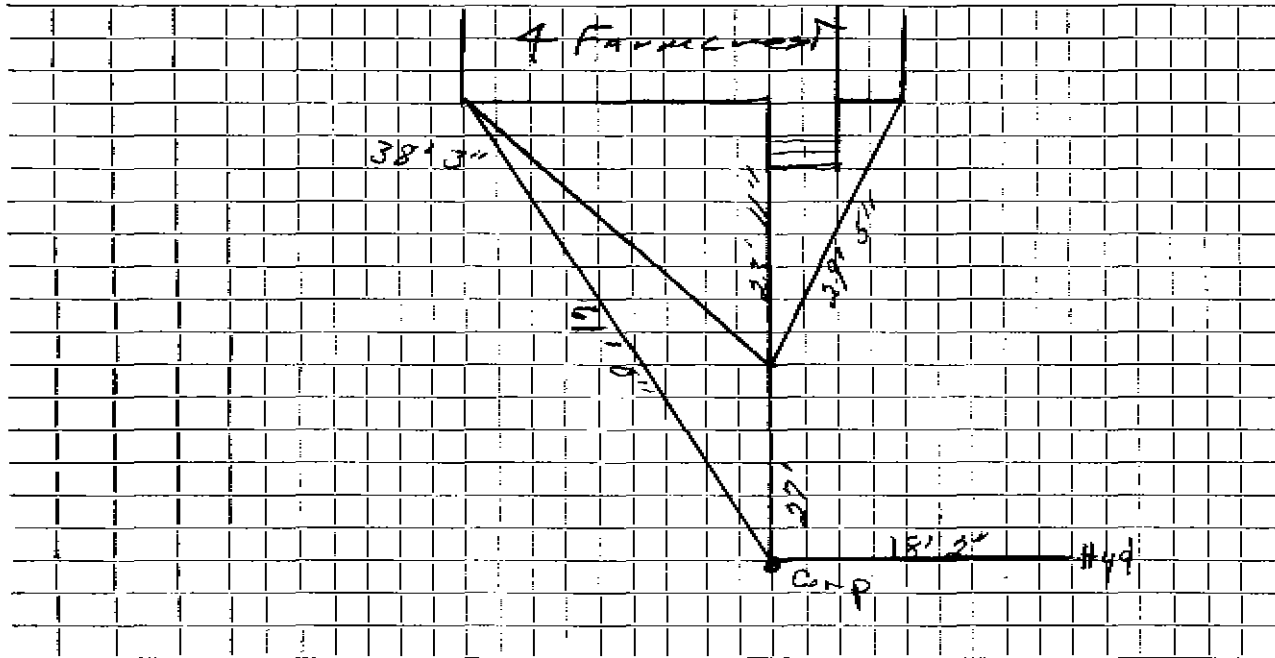

Connection made in Street. Work completed

Remarks:
.....
.....