


DATE 5/29/19

TOWN OF LEXINGTON — BOARD OF PUBLIC WORKS

WATER DIVISION

Sketch of Service Here

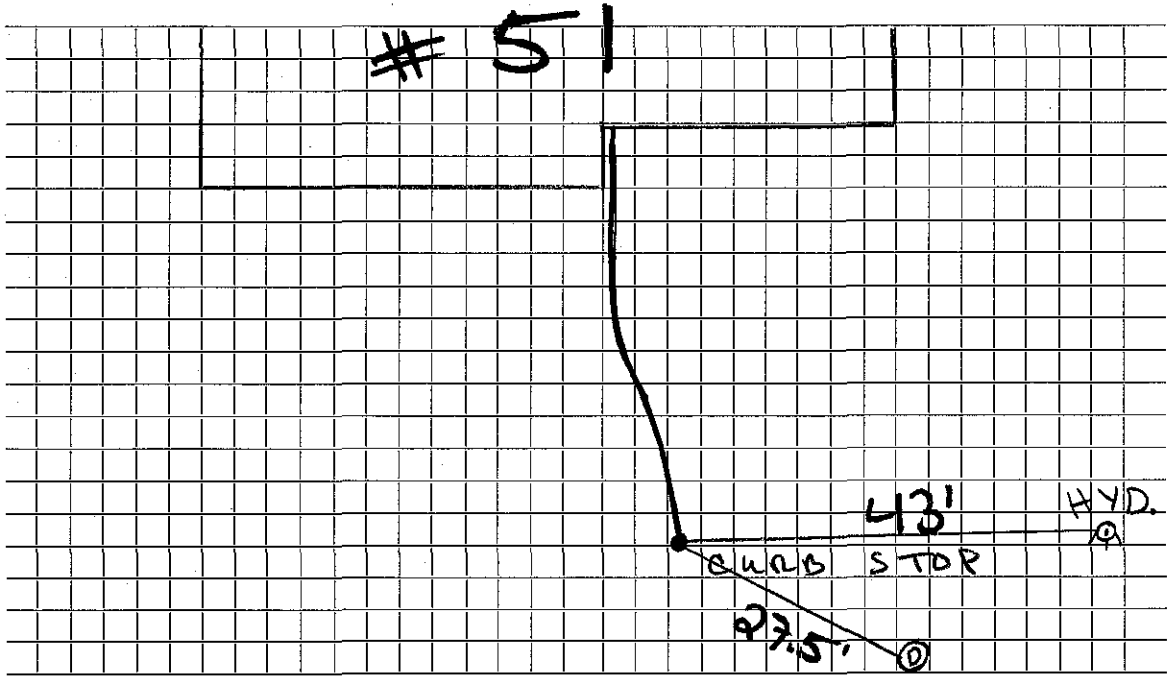

Connection made in Farmcrest Ave Street.

Work completed .....

Remarks: .....

.....

.....

