

WATER SERVICE RECORD

Name *Hugh Jackson*

Service No.

Address *52 Farmcrest Avenue*

Location

Repair—Renewal—New Service


Comm. *12/16/46*

Date	Material	Amount	Total	Date	Amount
9/14/46	Labor	.90			
	10% O.H.	.09	.99		
	33' 3/4" Copper tubing @ .23		7.59		
	1 3/4" C x 1/2" I.W.H.S & W		2.82		
				9/14/46	
					OUTSIDE
					Labor
					\$14.54
				21'	3/4" Copper tubing @ .23
					4.83
				1	3/4" C Corp-cock
					2.70
				1	3/4"C x 3/4"c Curb Cock
					3.30
				1	Box & Rod
					3.50
				1	1/2" Straight Tail Piece
					.50
				1	1/2" Offset Tail Piece
					.50
				2	hrs. Compressor @ 1.75
					3.50
				1	hr. Trucking @ .75
					.75
					34.12
				1985	18.7' 3/4" Copper
					Box & Rod
					1" Corp.
					1' Copper
					3/4" x 1" Reducer

DATE _____

TOWN OF LEXINGTON — BOARD OF PUBLIC WORKS
WATER DIVISION

Sketch of Service Here

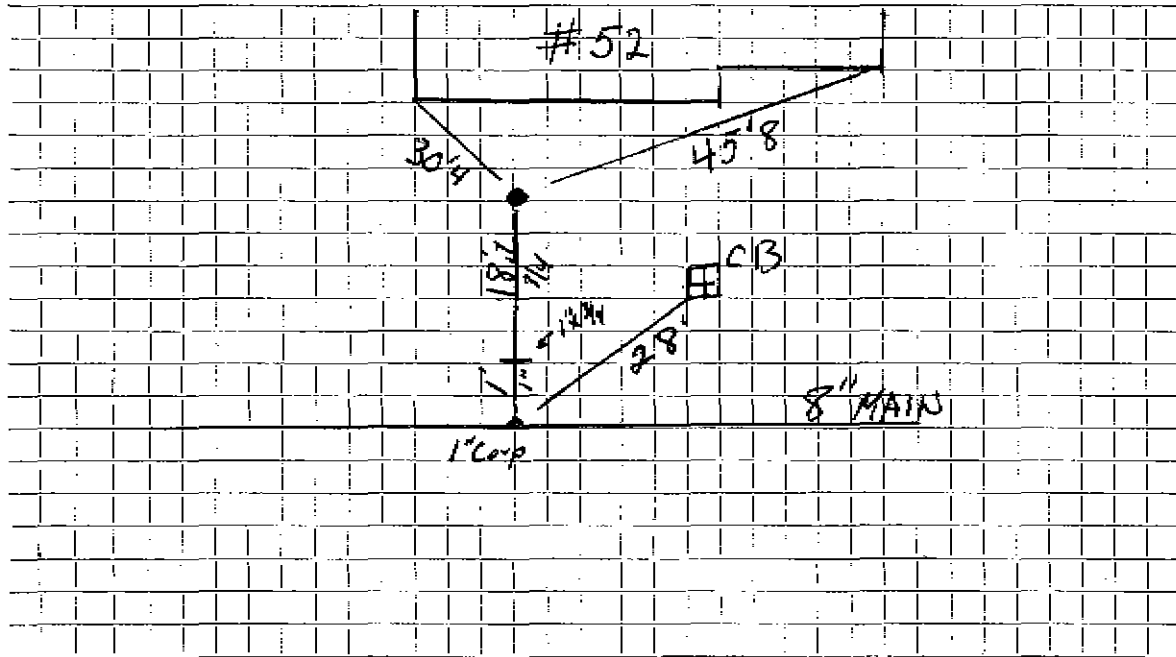

Connection made in Street. Work completed

Remarks:

.....

.....