

WATER SERVICE RECORD

Name William Casey

Service No. 91

Address 54 Farncrest Avenue

2086

Location

Repair ~~Renewal~~ - New Service

Am. 7-13-53


Date	Material	Amount	Total	Date	Amount
6/18/53	Labor	1 75		5-7-53 Deposited	25 00
	10% overhead	18	1 93	7-13-53 Refunded	(2 28)
	42' - 3/4" copper tubing@.37		15 54		NON CHARGE
	1 -3/4" Cx $\frac{3}{8}$ I.W.H. stop&waste		4 00	6/18/53 Labor	1 75
	1 hr. trucking		75	15'-3/4" copper tubing@.37	8 88
			22 22	1 -3/4" C. corp-cock	4 33
				1 -3/4" Cx 3/4" C. curb-cock	4 67
				1 box and rod	3 90
				1 - $\frac{3}{8}$ straight tail pc.	50
				1 - $\frac{3}{8}$ offset tail pc.	50
				2 hrs. Littlefield shovel@7.50	15 00
				1 hr. trucking	75
					40 28
				1985 1' 1" Copper	
				1" Corp	
				3/4" x 1" Reducer	

DATE _____

TOWN OF LEXINGTON — BOARD OF PUBLIC WORKS

WATER DIVISION

Sketch of Service Here

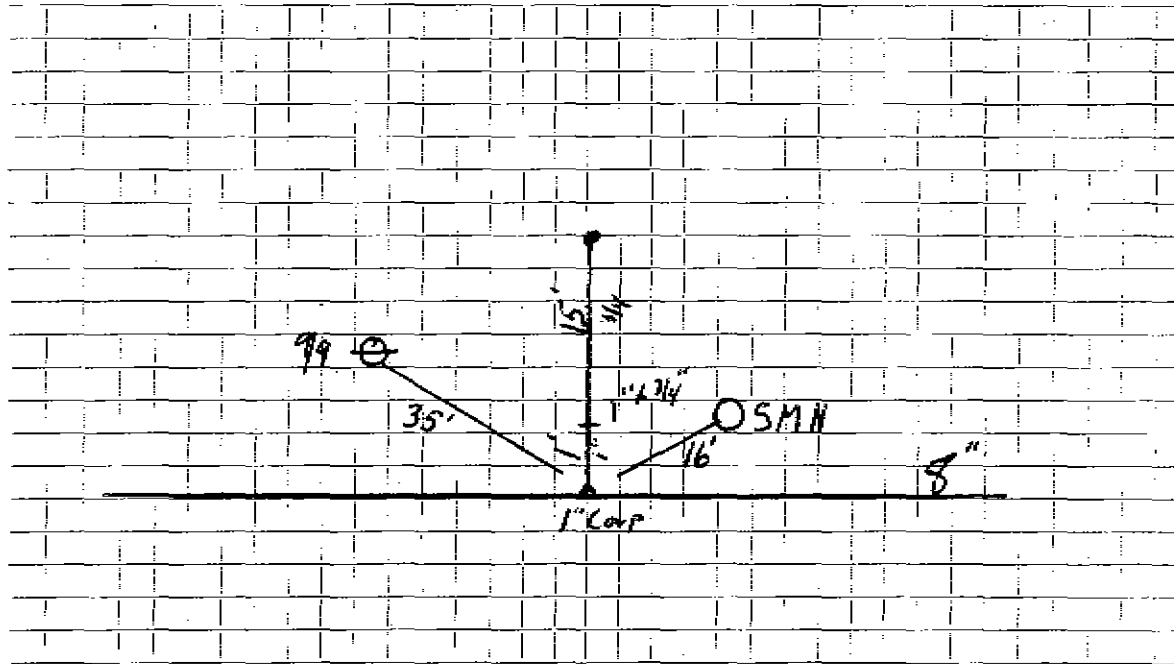

Connection made in Street. Work completed

Remarks:

.....
.....