

WATER SERVICE RECORD

Name George Hunt

Service No. 218

Address 58 Farmcrest Avenue


Location Lexington, Mass

Repair—Renewal—New Service *Com. 10/1/51*

Date	Material	Amount	Total	Date	Amount
8-9-51	Labor	1 49	1 49		
	10% Overhead		15	11-27-51	<i>18 45</i>
	37'-3/4" Copper Tubing @.326		12 06		
	1-3/4" Cx 1/2" I.W.H. S&W		1 00		No Charge
	1 Hr. Trucking		75	8-9-51	Labor 1 49
			18 45	8-10-51	Labor 16 76
			18	22'-3/4" Copper Tubing @.326	7 17
				<del>3-3/4" C. Serp Cook</del>	4 33
				1-3/4" Cx 3/4" C Curb-Cock	4 67
				1 Box & Rod	4 68
				1-1/2 Straight Tail Piece	50
				1-1/2 Offset Tail Piece	50
				1 Hr. Trucking	75
				1985 1' 1" Copper	40 85
				1" Corp	
				3/4" x 1" Reducer	

TOWN OF LEXINGTON — BOARD OF PUBLIC WORKS  
WATER DIVISION

Sketch of Service Here

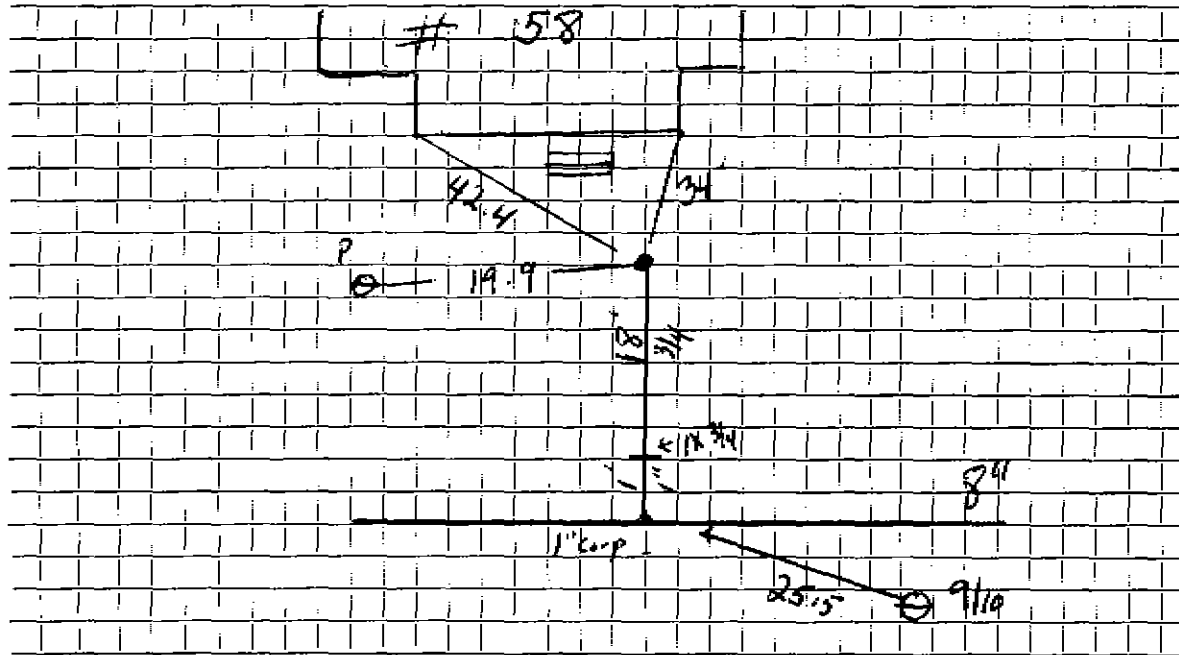

Connection made in ..... Street. Work completed .....

Remarks: .....

.....

.....