

WATER SERVICE RECORD

Name Louis J. Visco

Service No. 53

Address 6 Farmcrest Avenue

3655

Location Lexington, Mass.

Repair—Renewal—~~New Service~~


Com. 5-21-51

Date	Material	Amount	Total	Date	Amount
4-12-51	Labor	1 65	1 65	April 9 '51	20 00
	10% Overhead		17		17
	32' - 3/4" Copper Tubing @.36	11 52	11 52		No Charge
	1 - 3/4" C x 1/2" I.W.E. S&W	4 00	4 00	4-12-51	Labor
	Trucking 1 hr. @.75		75		18 09
			18 09	25' - 3/4" Copper Tubing @.36	9 00
				1 - 3/4" C Corp-cock	4 33
				1 - 3/4" C x 3/4" C Curb-cocks	4 67
				1 - Box & Rod	4 68
				1 - 1/2" Straight Tail Pieces	50
				1 - 1/2" Offset Tail Pieces	50
				Trucking 1 hr. @.75	75
					26 08

DATE _____

TOWN OF LEXINGTON — BOARD OF PUBLIC WORKS
WATER DIVISION

Sketch of Service Here

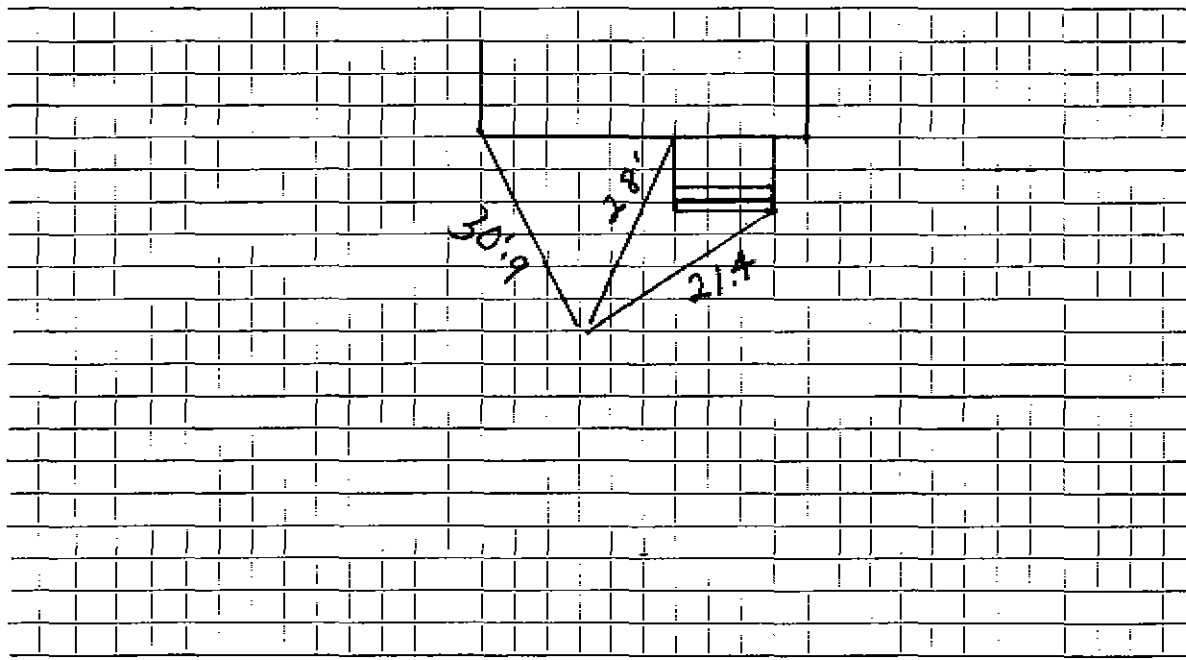

Connection made in Street. Work completed

Remarks:
.....
.....